

## Gas Works Park – Cracking Tower Work/Repairs

September 9, 2025

### **Introduction**

As requested by Landmarks Board staff, below is a brief overview describing work by SPR on the fence surrounding the Cracking Towers at Gas Works Park and other actions to deter climbing of the towers. This is cursory and not intended to be a thorough history of the site. The timelines are approximate and based off memory.

### **Background**

The fence around the Cracking Towers is considered an Institutional Control as part of the Consent Decree for the upland cleanup work and maintenance and improvement, if necessary, of the fence is required. Pursuant to the Consent Decree, Seattle Parks & Recreation (SPR) Staff inspect the soil cover and fence on a regular (approximately weekly) basis, needed repairs are typically handled through SPR's work order system, minor work that can be done by the grounds crew in the regular course of their activities at the park may not generate a work order. In addition, the Northeast District maintenance staff are at the park on a daily basis and also call-in work orders if they see issues with the fence or gates.

### **Timeline (approximate)**

June 26, 2015 – Landmarks Preservation Board (LPB) – Architectural Review Committee (ARC) briefing to discuss removing some or all of the stairs and landings to deter climbing of the south towers. ARC suggested starting with more focused removals of obvious access points.

2016 - SPR hires PSM Consulting Engineers to undertake a Climbing and Safety Evaluation of Towers 1 & 2 (southerly large towers).

August 7, 2019 – LPB issues Certificate of Approval (CoA) to allow SPR to perform selective removal of climbable features and undertake limited alterations to Towers 1 & 2 to deter climbing.

2019-2023 – SPR Metal Shop Crew undertakes approved work on Towers 1 & 2. Ongoing repairs were also being made to the fence and gates intermittently, as it was cut or otherwise manipulated/vandalized, ostensibly to gain access into the restricted area.

2023 – SPR hired All City Fence to do a complete restoration of the chain-link fence, restore the barbed wire on top of the fence, add steel mesh panels over the chain-link and reconstruct the gates with the steel mesh to resist cutting and strengthen the gates.

2023 – SPR hired a landscape contractor to remove all vegetation and trees that were growing around and amongst the towers to make the area more open and remove potential access point(s) to the towers. Note that SPR crews have been and continue to remove blackberries and mow the lawn areas around the towers within the Cracking Tower fenced area. They generally avoid working directly under the towers due to safety concerns/potential falling metal.

2024 – A leaning support element within the Cracking Tower area, between the North and South Towers, was removed with a CoA from LPB issued on June 26, 2024

2023-2025 – SPR facilities continues to address access points; 3 of the 4 gates have been welded shut; area(s) under the gates have been paved to strengthen the gates and limit the possibility of digging under a gate.

## Incidents

The following is a list of incidents at the Cracking Towers since 2008. This list is based on aid calls that Seattle Fire Department (SFD) responded to and has been provided by SFD:

Date and Time	Victim Details	Description	Outcome
10/11/2008 0400 hours	Male, age 22	Climbed fenced-off structure; catwalk gave way, fell onto another catwalk.	Non-life-threatening (possible dislocated shoulder)
12/13/2009 0023 hours	Female (age 25)	Fell off structure.	Life-threatening injuries; survived
5/25/2012 0010 hours	Male, age 19	Fell off towers. Was visiting Seattle from Massachusetts.	Death
3/29/2013 0517 hours	Male (age 19)	Fell off structure; unconscious with liver and head injuries.	Life-threatening injuries; survived
7/19/2014 0322 hours	Female, 19	Fell 35 feet while writing graffiti.	Multiple broken bones; survived

Date and Time	Victim Details	Description	Outcome
1/25/2015	Male	Fell off structure.	Life-threatening head and internal injuries; survived
0033 hours	(age 21)		
2/1/2015	Male	Fell off structure but remained conscious.	Injuries; transported to HMC
2210 hours	(age 19)		
12/11/2016	Male	Fell off structure while intoxicated after he missed a hole in catwalk; rescued by SFD.	Open femur fracture, possible pelvic fracture, etc.; survived
2213 hours	(age 23)		
1/1/2019	Male	Climbed while intoxicated; fell.	Significant injuries; survived
2213 hours	(age 40)		
2/21/2022	Male	Fell off structure; rescued by SFD.	Broken leg, head laceration; survived
0117 hours	(age 26)		
9/17/2022	Female	Fell through an opening in the walkway while climbing with friends on the south towers. They had all been drinking.	Death
0242 hours	(age 20 )		
	Only known female victim.		
11/23/2023	Male	Fell off refinery; unconscious, no pulse.	Survived with brain damage.
0030 hours	(age 16)		
3/29/2024	Male	Fell 60 feet; walking and talking.	Injuries; treated at HMC
2318 hours	(age 19)		
7/10/2025	Male	Fell off towers after a classical music concert in the park.	Death
2230 hours	(age 15)		

# Gas Works Park Cracking Towers Tower Photographs

---

David Graves, Strategic Advisor | September 10, 2025



Healthy People, Thriving Environment, Vibrant Community

#SeattleShines





2

#SeattleShines







4

#SeattleShines









7

#SeattleShines



















# GAS WORKS PARK "CRACKING TOWERS": EMERGENCY SELECTIVE DECONSTRUCTION

1901 N NORTHLAKE WAY 98103



## PROJECT TEAM

### **OWNER**

SEATTLE PARKS AND RECREATIONS  
100 DEXTER AVE N, SEATTLE, WA,  
98109

**CONTACT:** MIKE SCHWINDELLER

**PHONE:** 206.615.1165

**EMAIL:**

MIKE.SCHWINDELLER@SEATTLE.GOV

### **ARCHITECT**

OSBORN ARCHITECTS INC., PS (OAI)  
1001 SW KICKITAT WAY, STE 204  
SEATTLE, WA 98134

**CONTACT:** JERRY OSBORN

**PHONE:** 206.920.6348

**EMAIL:** JOSBORN@OAIPI.COM

### **HAZMAT CONSULTANT**

**CONTACT:** RYAN HUNTER

**PHONE:** 484.269.2138

**EMAIL:** RYAN.HUNTER@PBSUSA.COM

## VICINITY MAP

GAS WORKS PARK - NOT TO SCALE

## SITE INFORMATION

**PROPERTY ADDRESS:** 1901 N NORTHLAKE WAY 98103

**OWNER:** SEATTLE PARKS AND RECREATION

**ZONING:** UI U/45

**PARCEL NUMBER:** 124970-0005

## SCOPE OF WORK

SELECTIVE REMOVAL OF PIPING, CATWALKS, LADDERS AND SUPPORT SYSTEMS FROM TOWER STRUCTURES LOCATED WITHIN GAS WORKS PARK. EMERGENCY SECURITY LIGHTING SYSTEMS.

## SHEET LIST

G1.00	COVER SHEET
D1.01	DECONSTRUCTION PERSPECTIVE RENDERINGS
D1.02	SELECTIVE DECONSTRUCTION PLAN
D1.03	WEST DECONSTRUCTION ELEVATION
D1.04	NORTH DECONSTRUCTION ELEVATION
D1.05	SOUTH DECONSTRUCTION ELEVATION
D1.06	EAST DECONSTRUCTION ELEVATION
D1.07	POST DECONSTRUCTION PERSPECTIVE RENDERINGS
D1.08	POST DECONSTRUCTION WEST ELEVATION
D1.09	POST DECONSTRUCTION NORTH ELEVATION
D1.10	POST DECONSTRUCTION SOUTH ELEVATION
D1.11	POST DECONSTRUCTION EAST ELEVATION

APPROVED FOR ADVERTISING:		
FAS PURCHASING AND CONTRACTING DIRECTOR		
Seattle, Washington _____ Date _____		
Signature: _____ Director, Purchasing & Contracting		
3	_____	
2	_____	
1	_____	
NO.	REVISION - AS BUILT	DATE
REVIEWED: PARK ENGINEER _____ DATE _____		
All work done in accordance with the City of Seattle Standard Plans and Specifications in effect on the date shown above, and supplemented by Special Provisions.		
6273 REGISTERED ARCHITECT Jerry D. Osborn STATE OF WASHINGTON		_____



1001 SW Klickitat Way, Ste #204 | Seattle, WA 98134  
p. (206) 631-8442 | <http://www.oaiips.com>



GAS WORKS PARK


EMERGENCY DEMOLITION

COVER SHEET


DESIGNED	Author	DATE	08/07/25
DRAWN	Designer		
CHECKED	Checker	SHEET	_____ OF _____
ORDINANCE NO. _____		CONTRACT NO. _____	
SCALE 1 1/2" = 1'-0" (U.N.O.)		G1.00	

**GENERAL NOTES**


- ITEMS RENDERED IN RED ARE SELECTED FOR REMOVAL AND DISPOSAL (TYP.)
- CUT-OFF VERTICAL FRAMING AT GROUND LEVEL
  - SOIL DISTURBANCE IS EXCLUDED FROM THIS PROJECT.
- CAPPING OF UTILITY PIPING IS INCLUDED IN THE SCOPE OF THIS PROJECT.

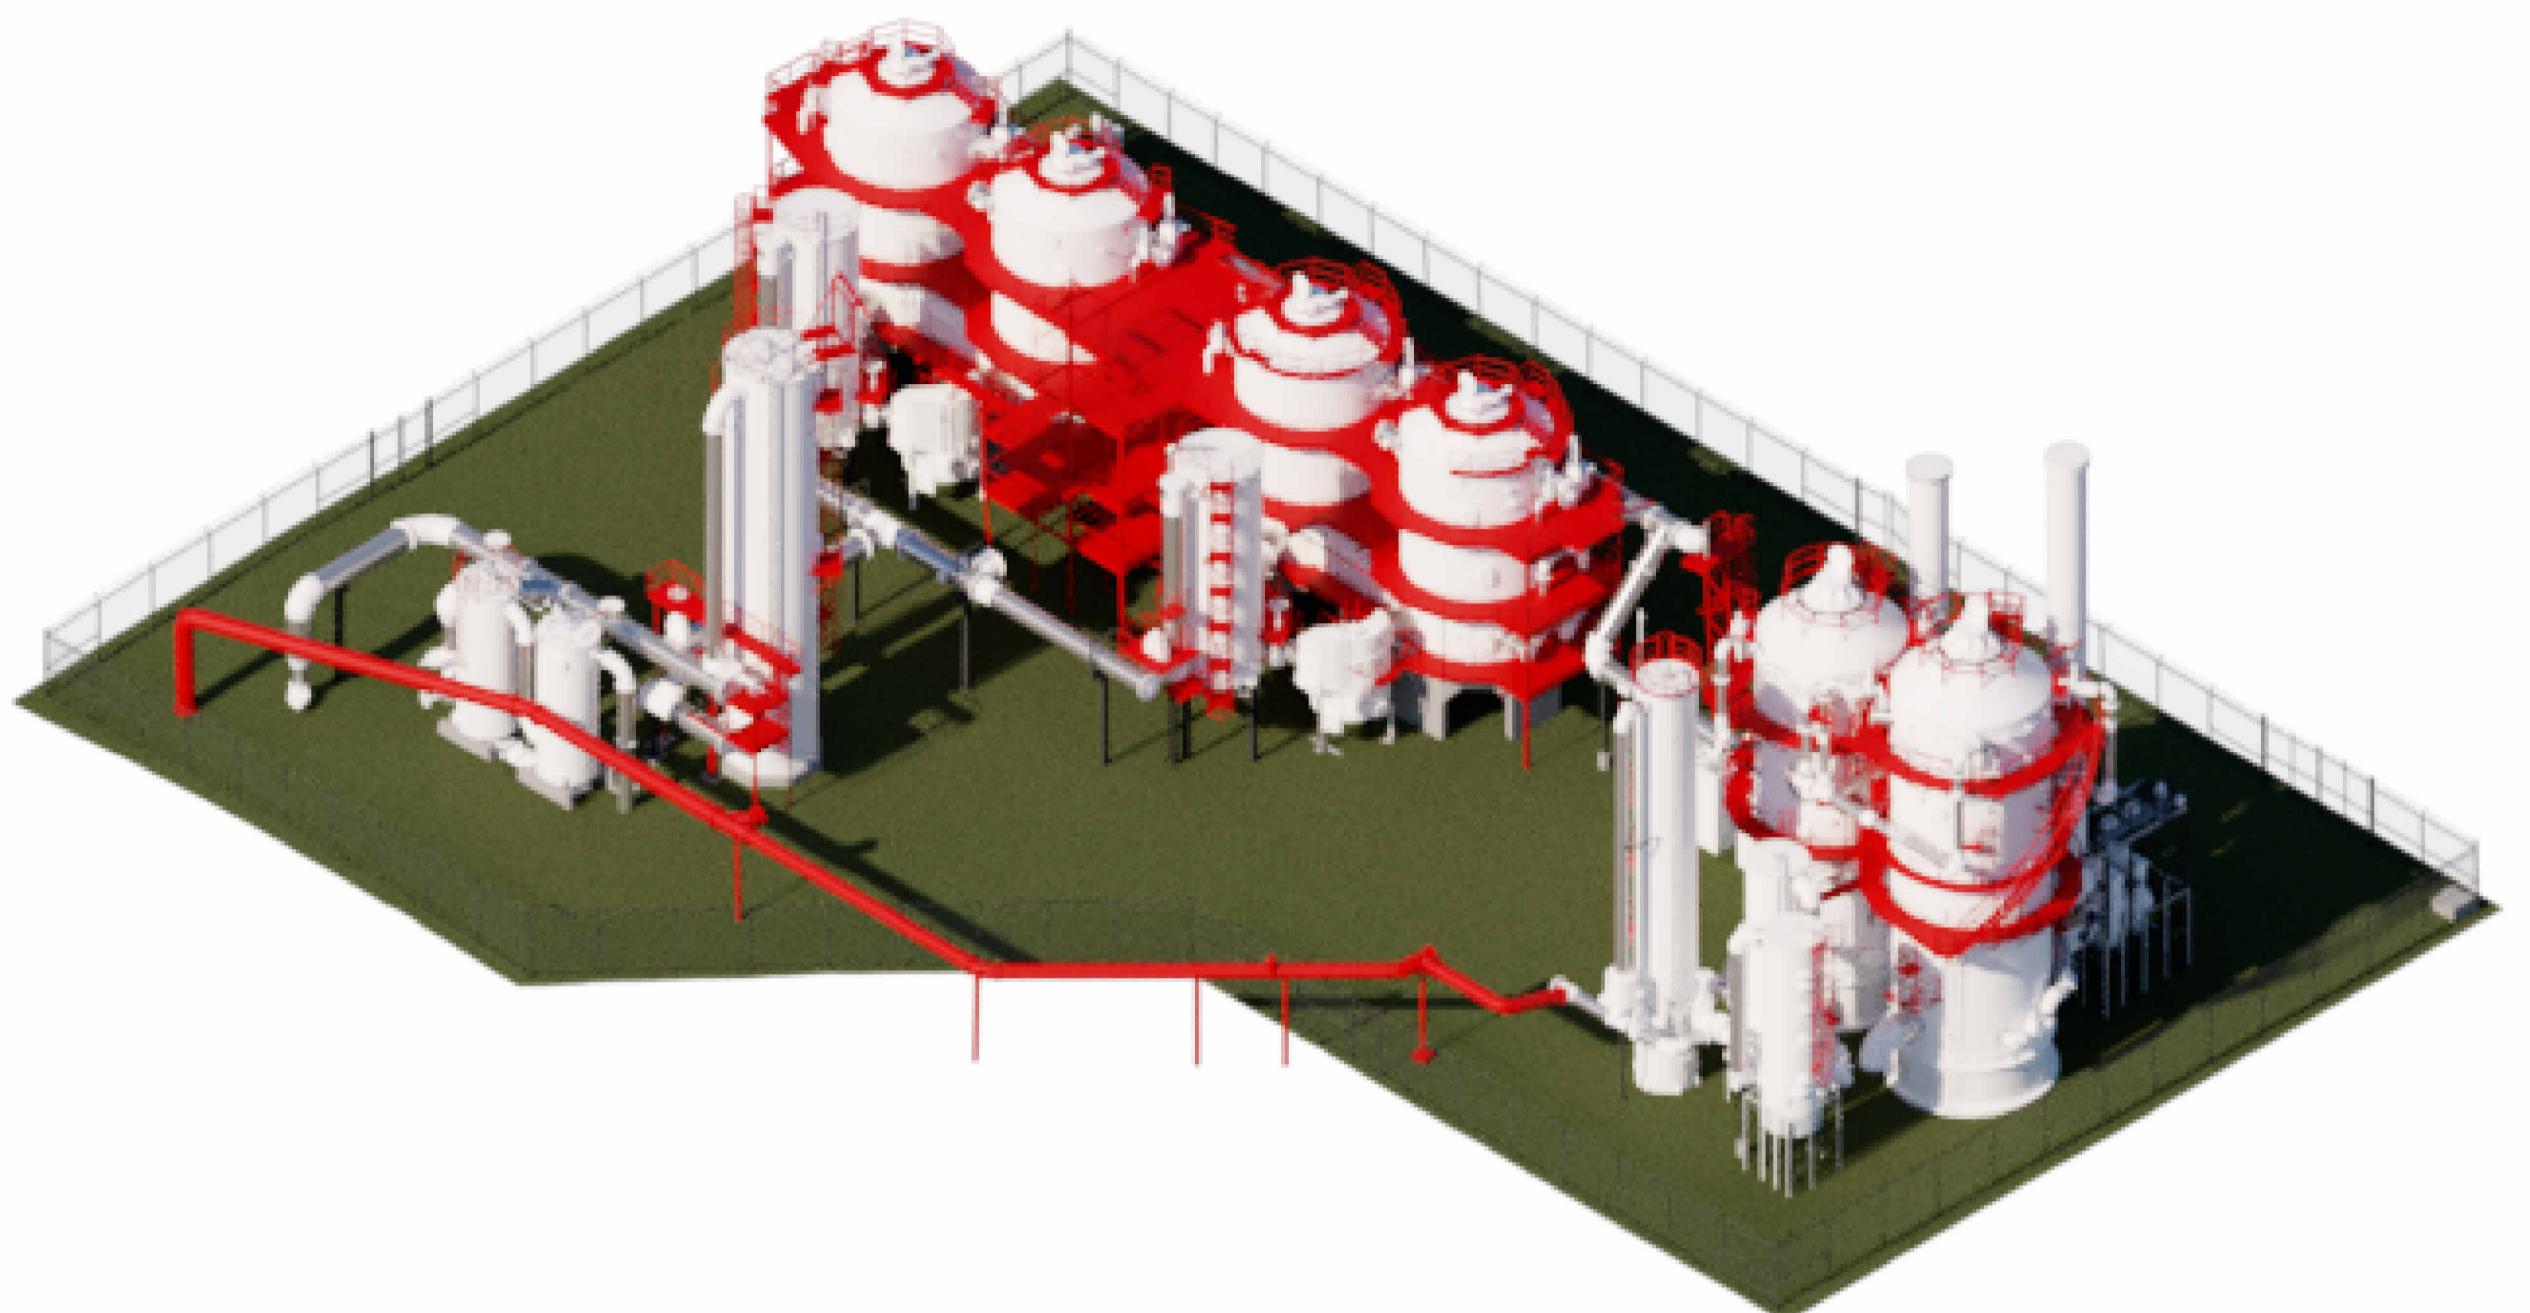


① SW PERSPECTIVE  
NTS

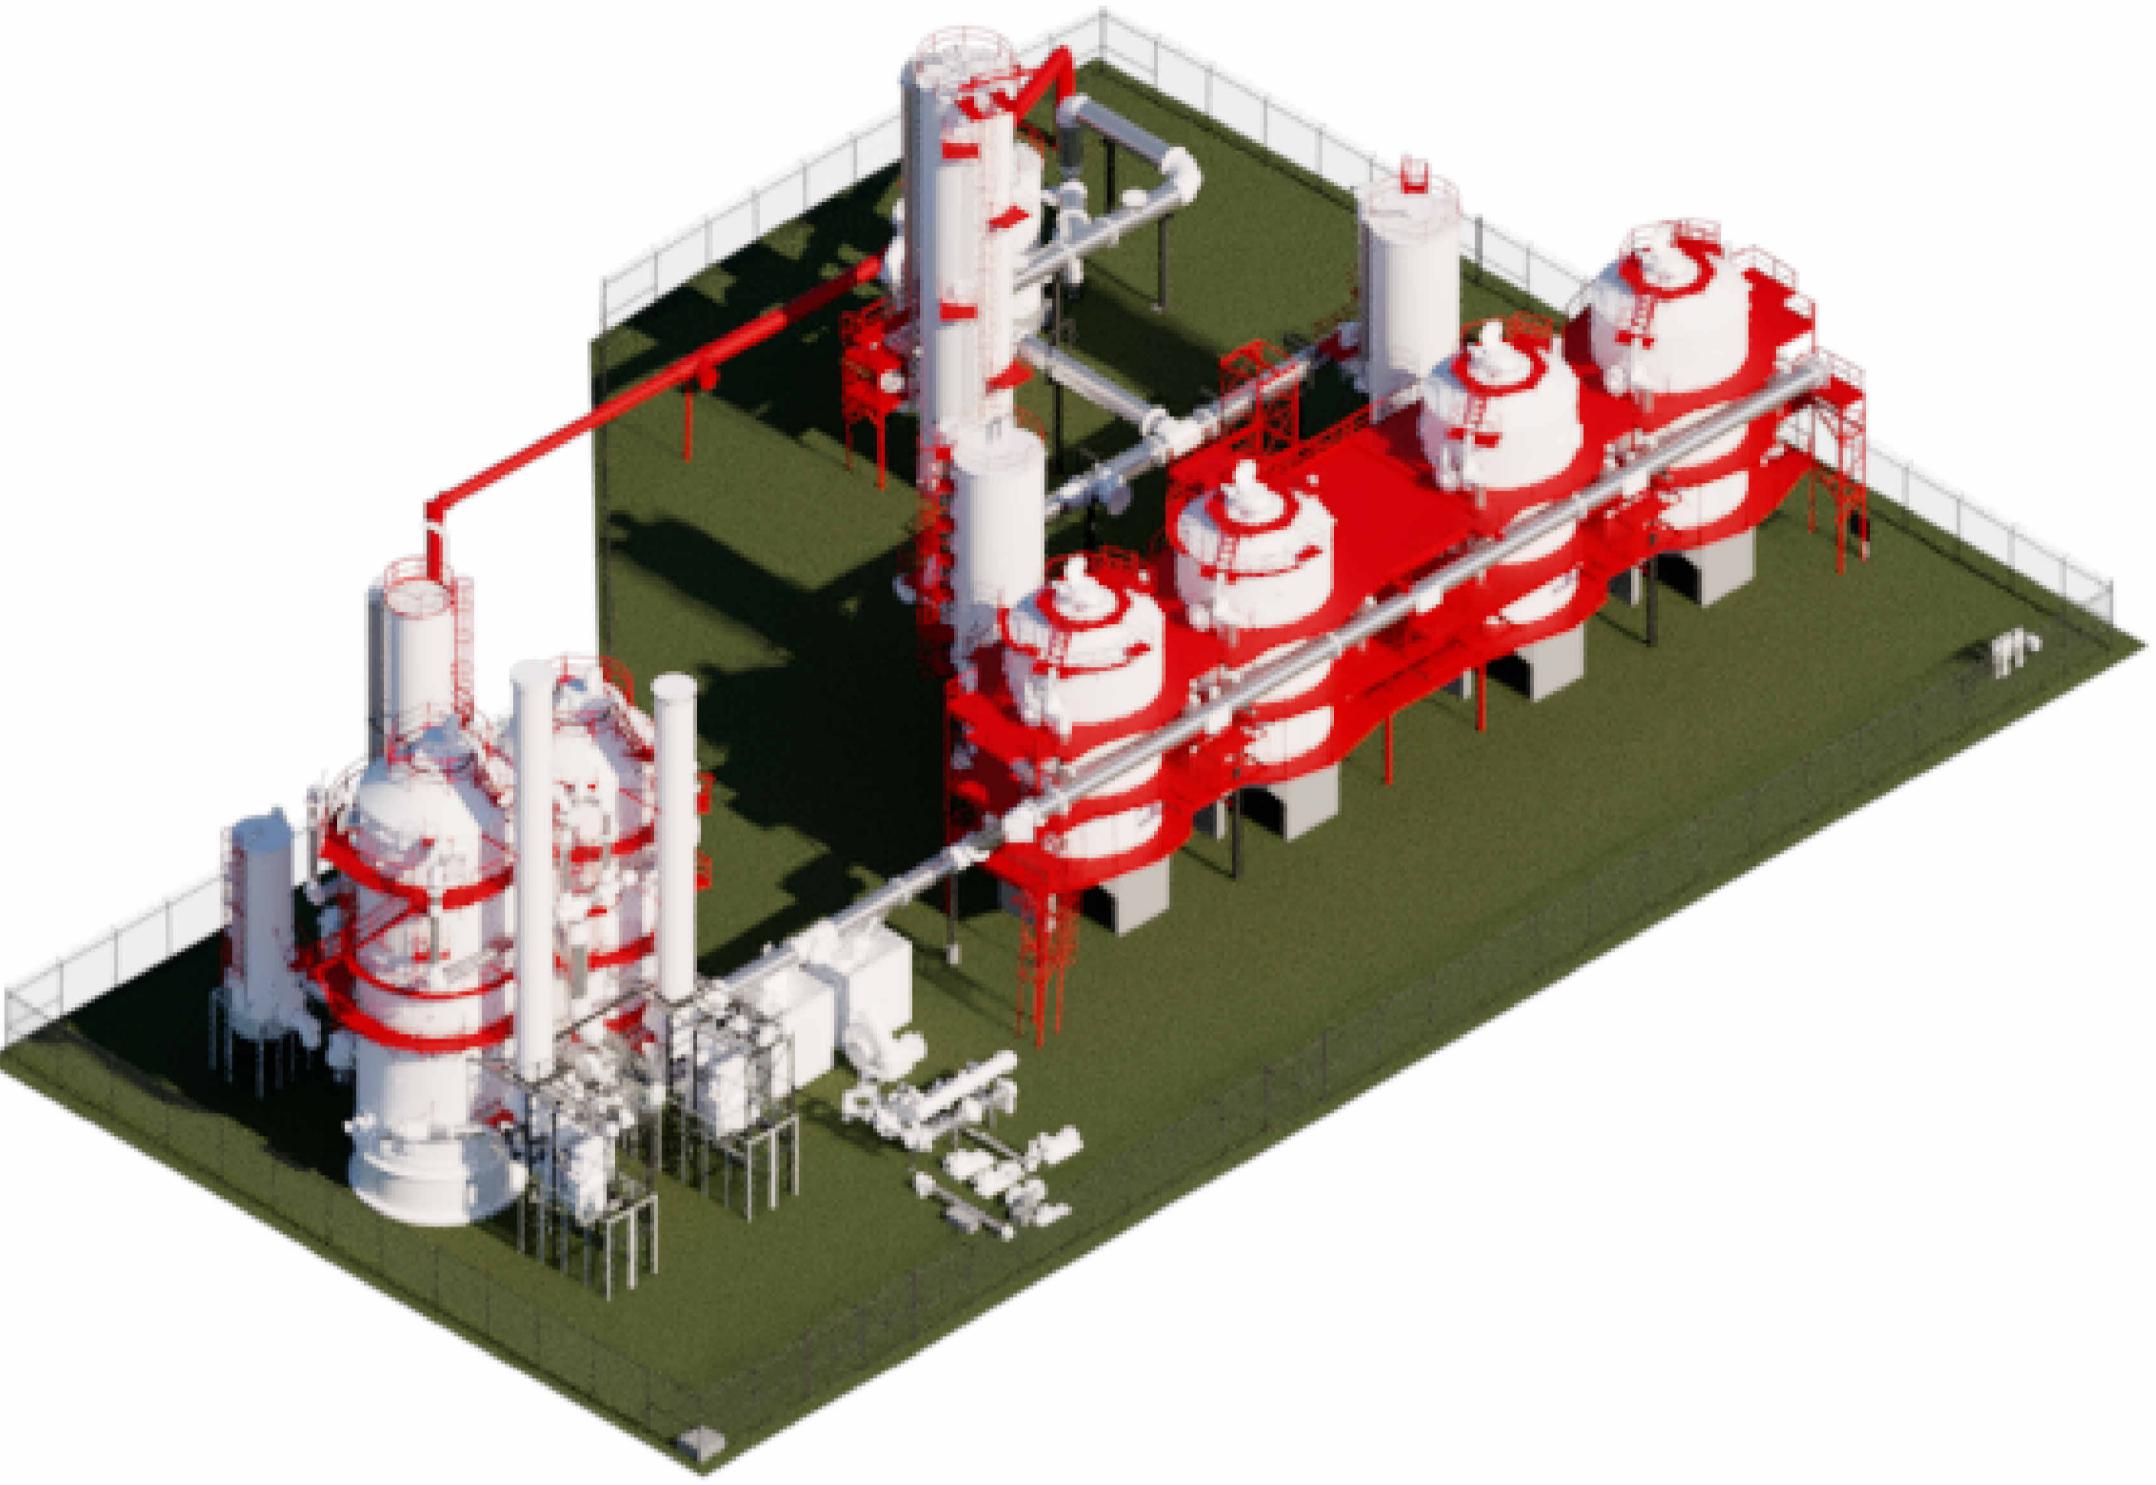

② SE PERSPECTIVE  
NTS

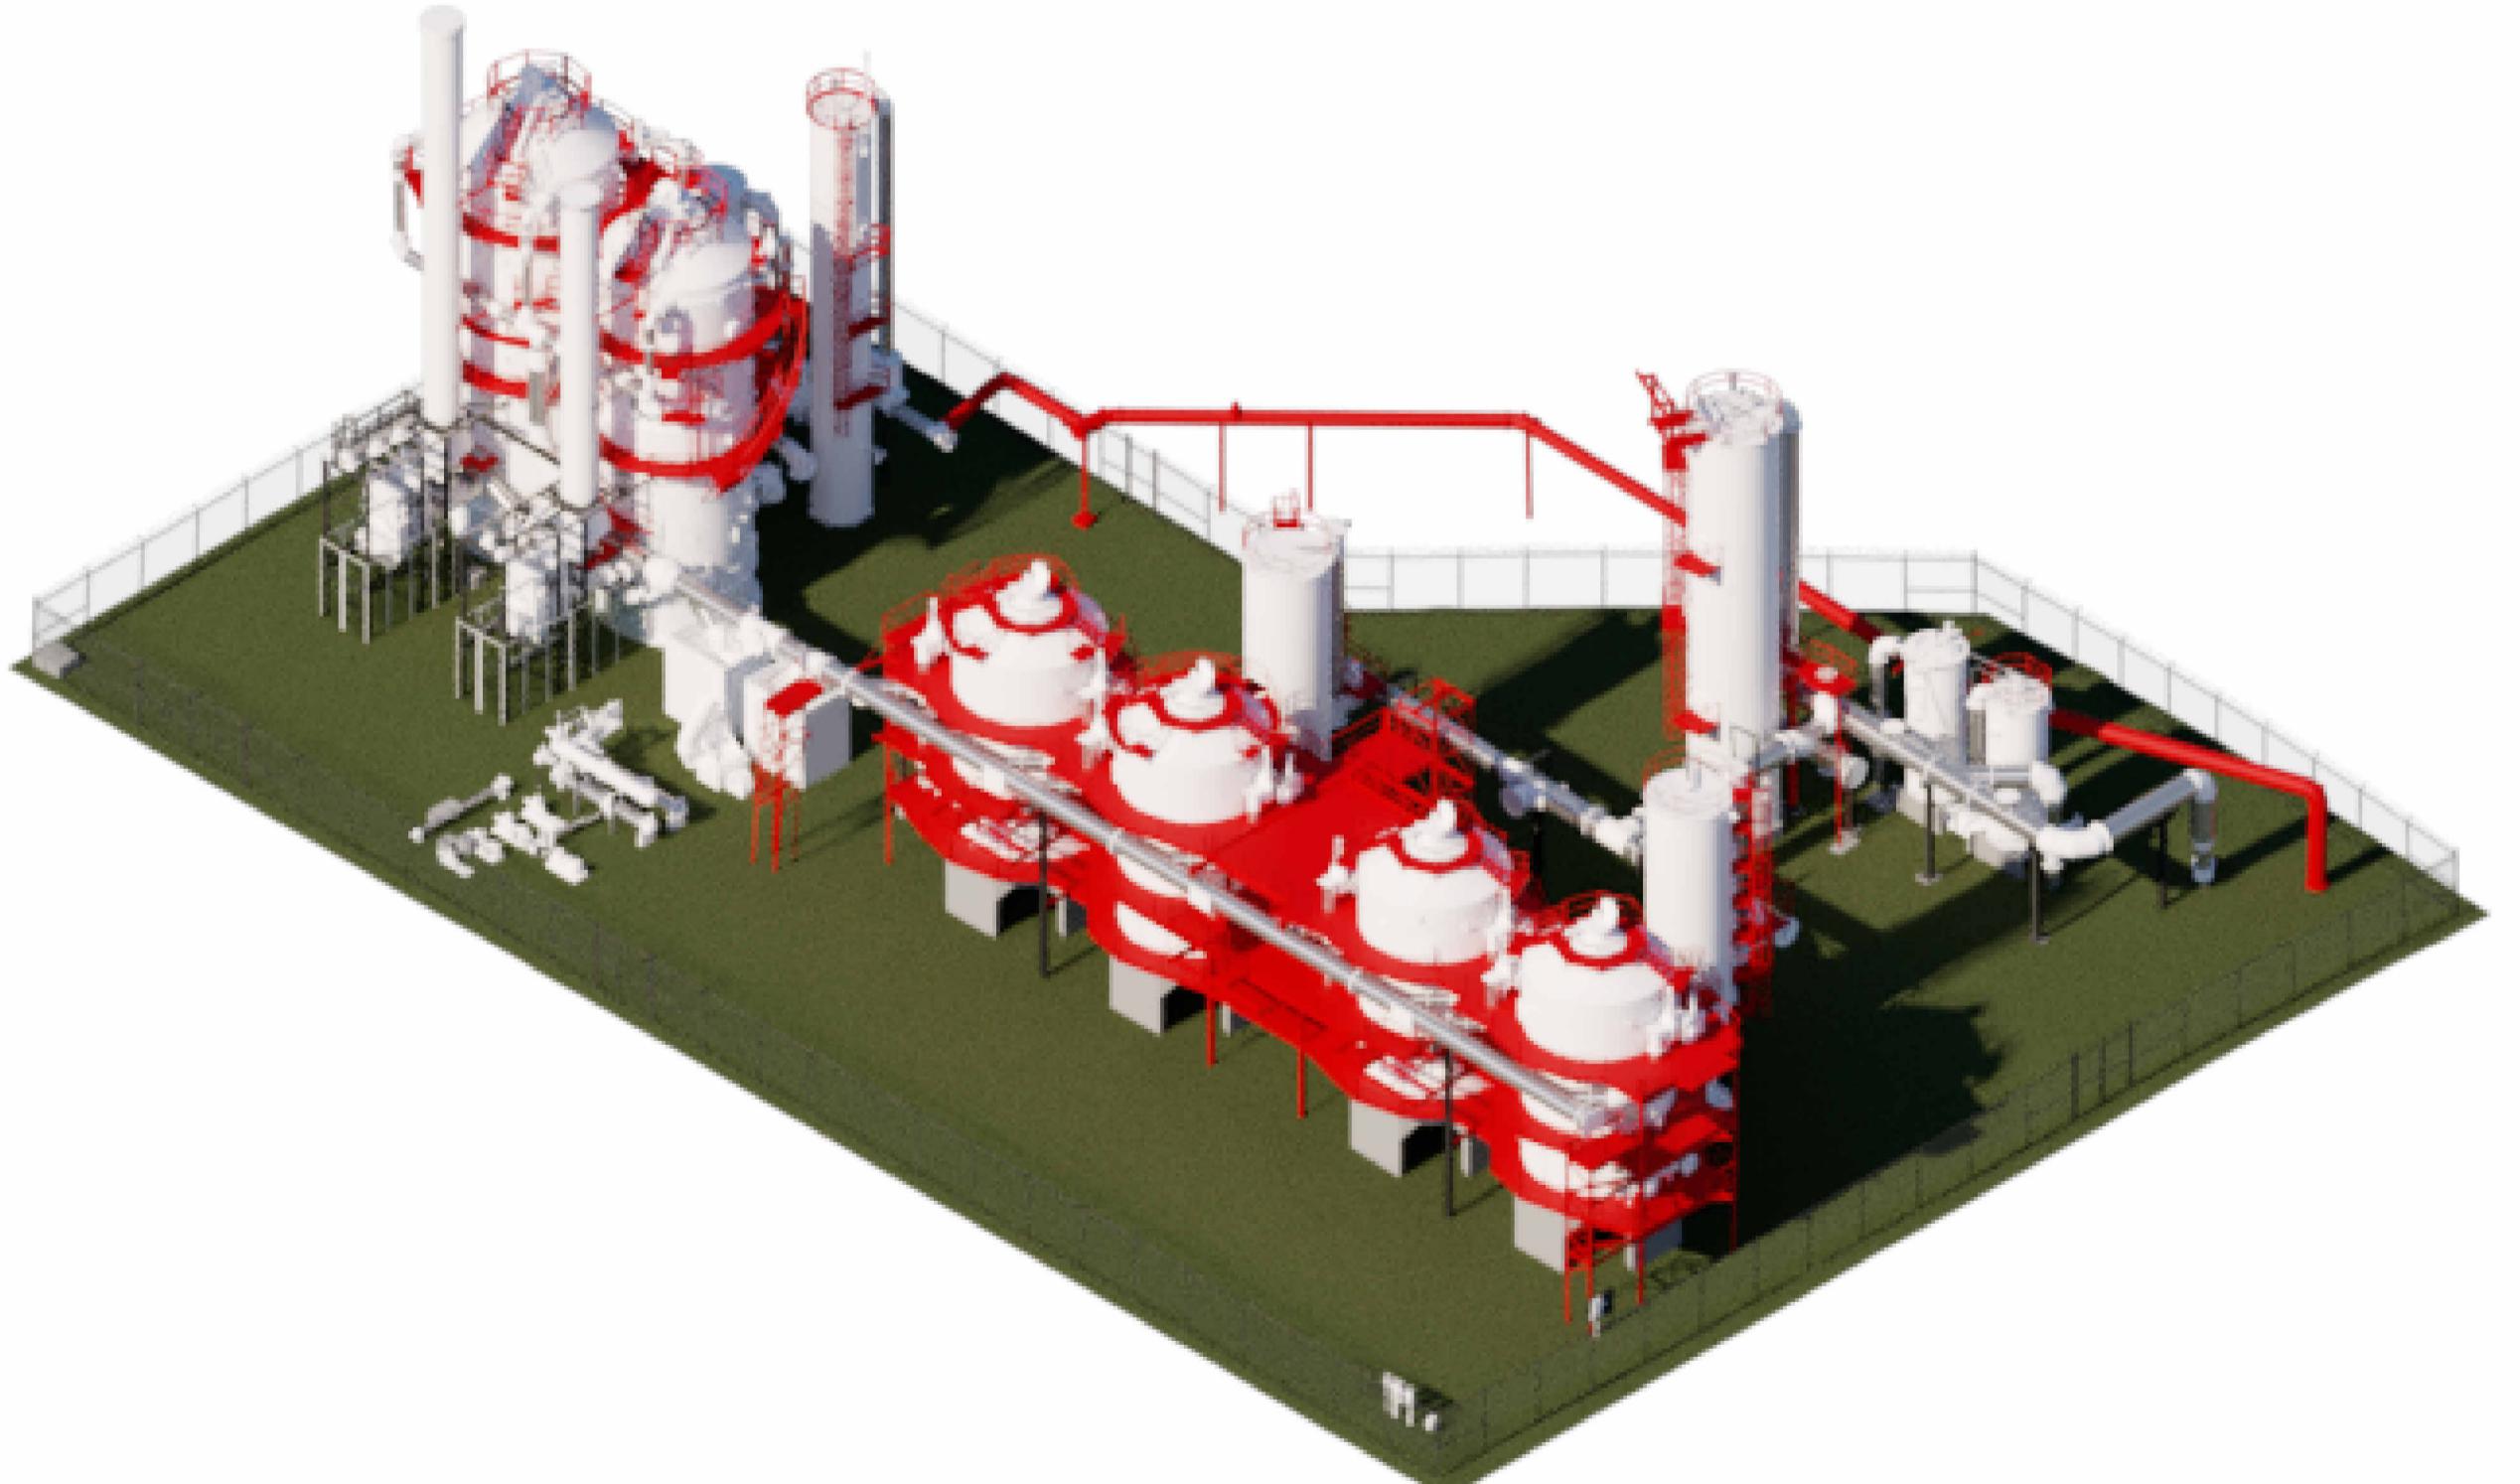

③ NE PERSPECTIVE  
NTS

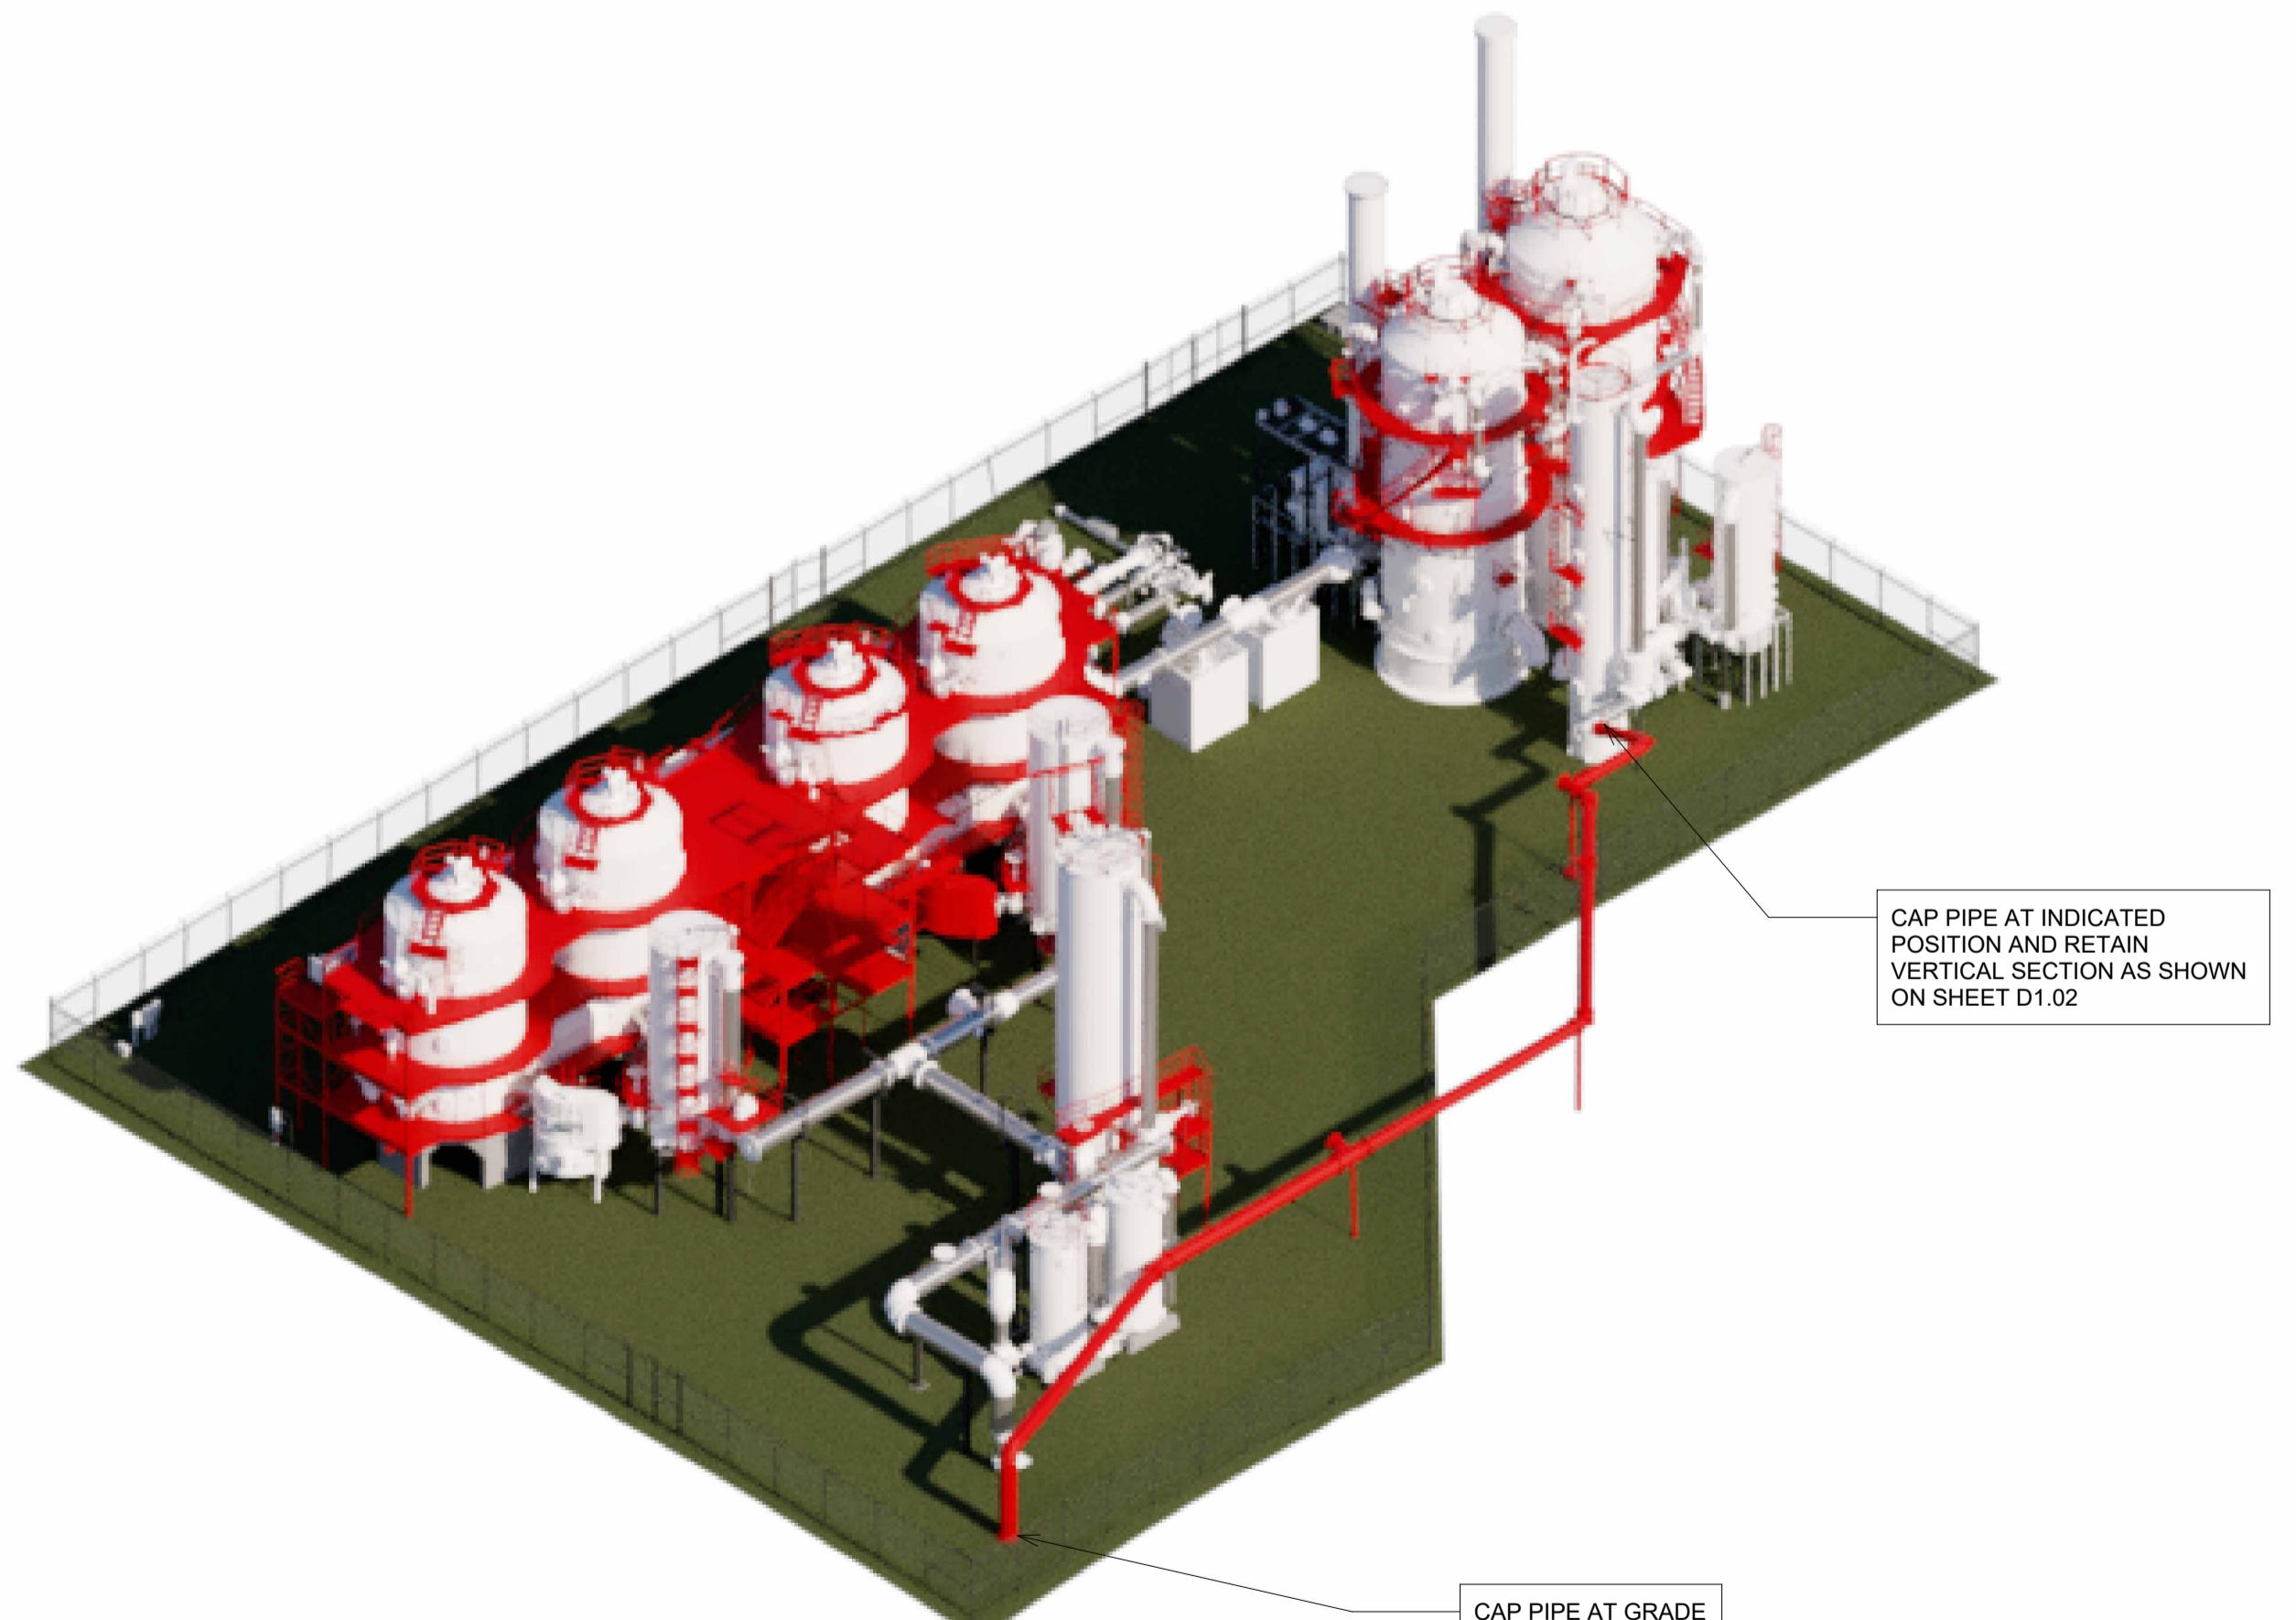

④ NW PERSPECTIVE  
NTS

APPROVED FOR ADVERTISING:  
FAS PURCHASING AND CONTRACTING DIRECTOR

Seattle, Washington \_\_\_\_\_ 20 \_\_\_\_\_  
Signature: \_\_\_\_\_ Director, Purchasing & Contracting

3 \_\_\_\_\_  
2 \_\_\_\_\_  
1 \_\_\_\_\_  
NO. REVISION - AS BUILT DATE

REVIEWED: PARK ENGINEER DATE  
All work done in accordance with the City of Seattle Standard Plans and Specifications in effect on the date shown above, and supplemented by Special Provisions.

6273 REGISTERED  
ARCHITECT  
Jerry D. Osborn  
STATE OF WASHINGTON

DAI ARCHITECTURE + PLANNING  
1001 SW Klickitat Way, Ste #204 | Seattle, WA 98134  
p. (206) 631-8442 | <http://www.oapis.com>

Seattle Parks & Recreation

GAS WORKS PARK

EMERGENCY DEMOLITION


DECONSTRUCTION  
PERSPECTIVE RENDERINGS

DESIGNED	Author	DATE	08/07/25
DRAWN	Designer		
CHECKED	Checker		
ORDINANCE NO.			
CONTRACT NO.			
SCALE	NTS	(U.N.O.)	

D1.01

**GENERAL NOTES:**

1. DECONSTRUCTION SHOWN ON THIS PLAN DOES NOT REPRESENT THE COMPLETE SCOPE OF DECONSTRUCTION REQUIREMENTS.

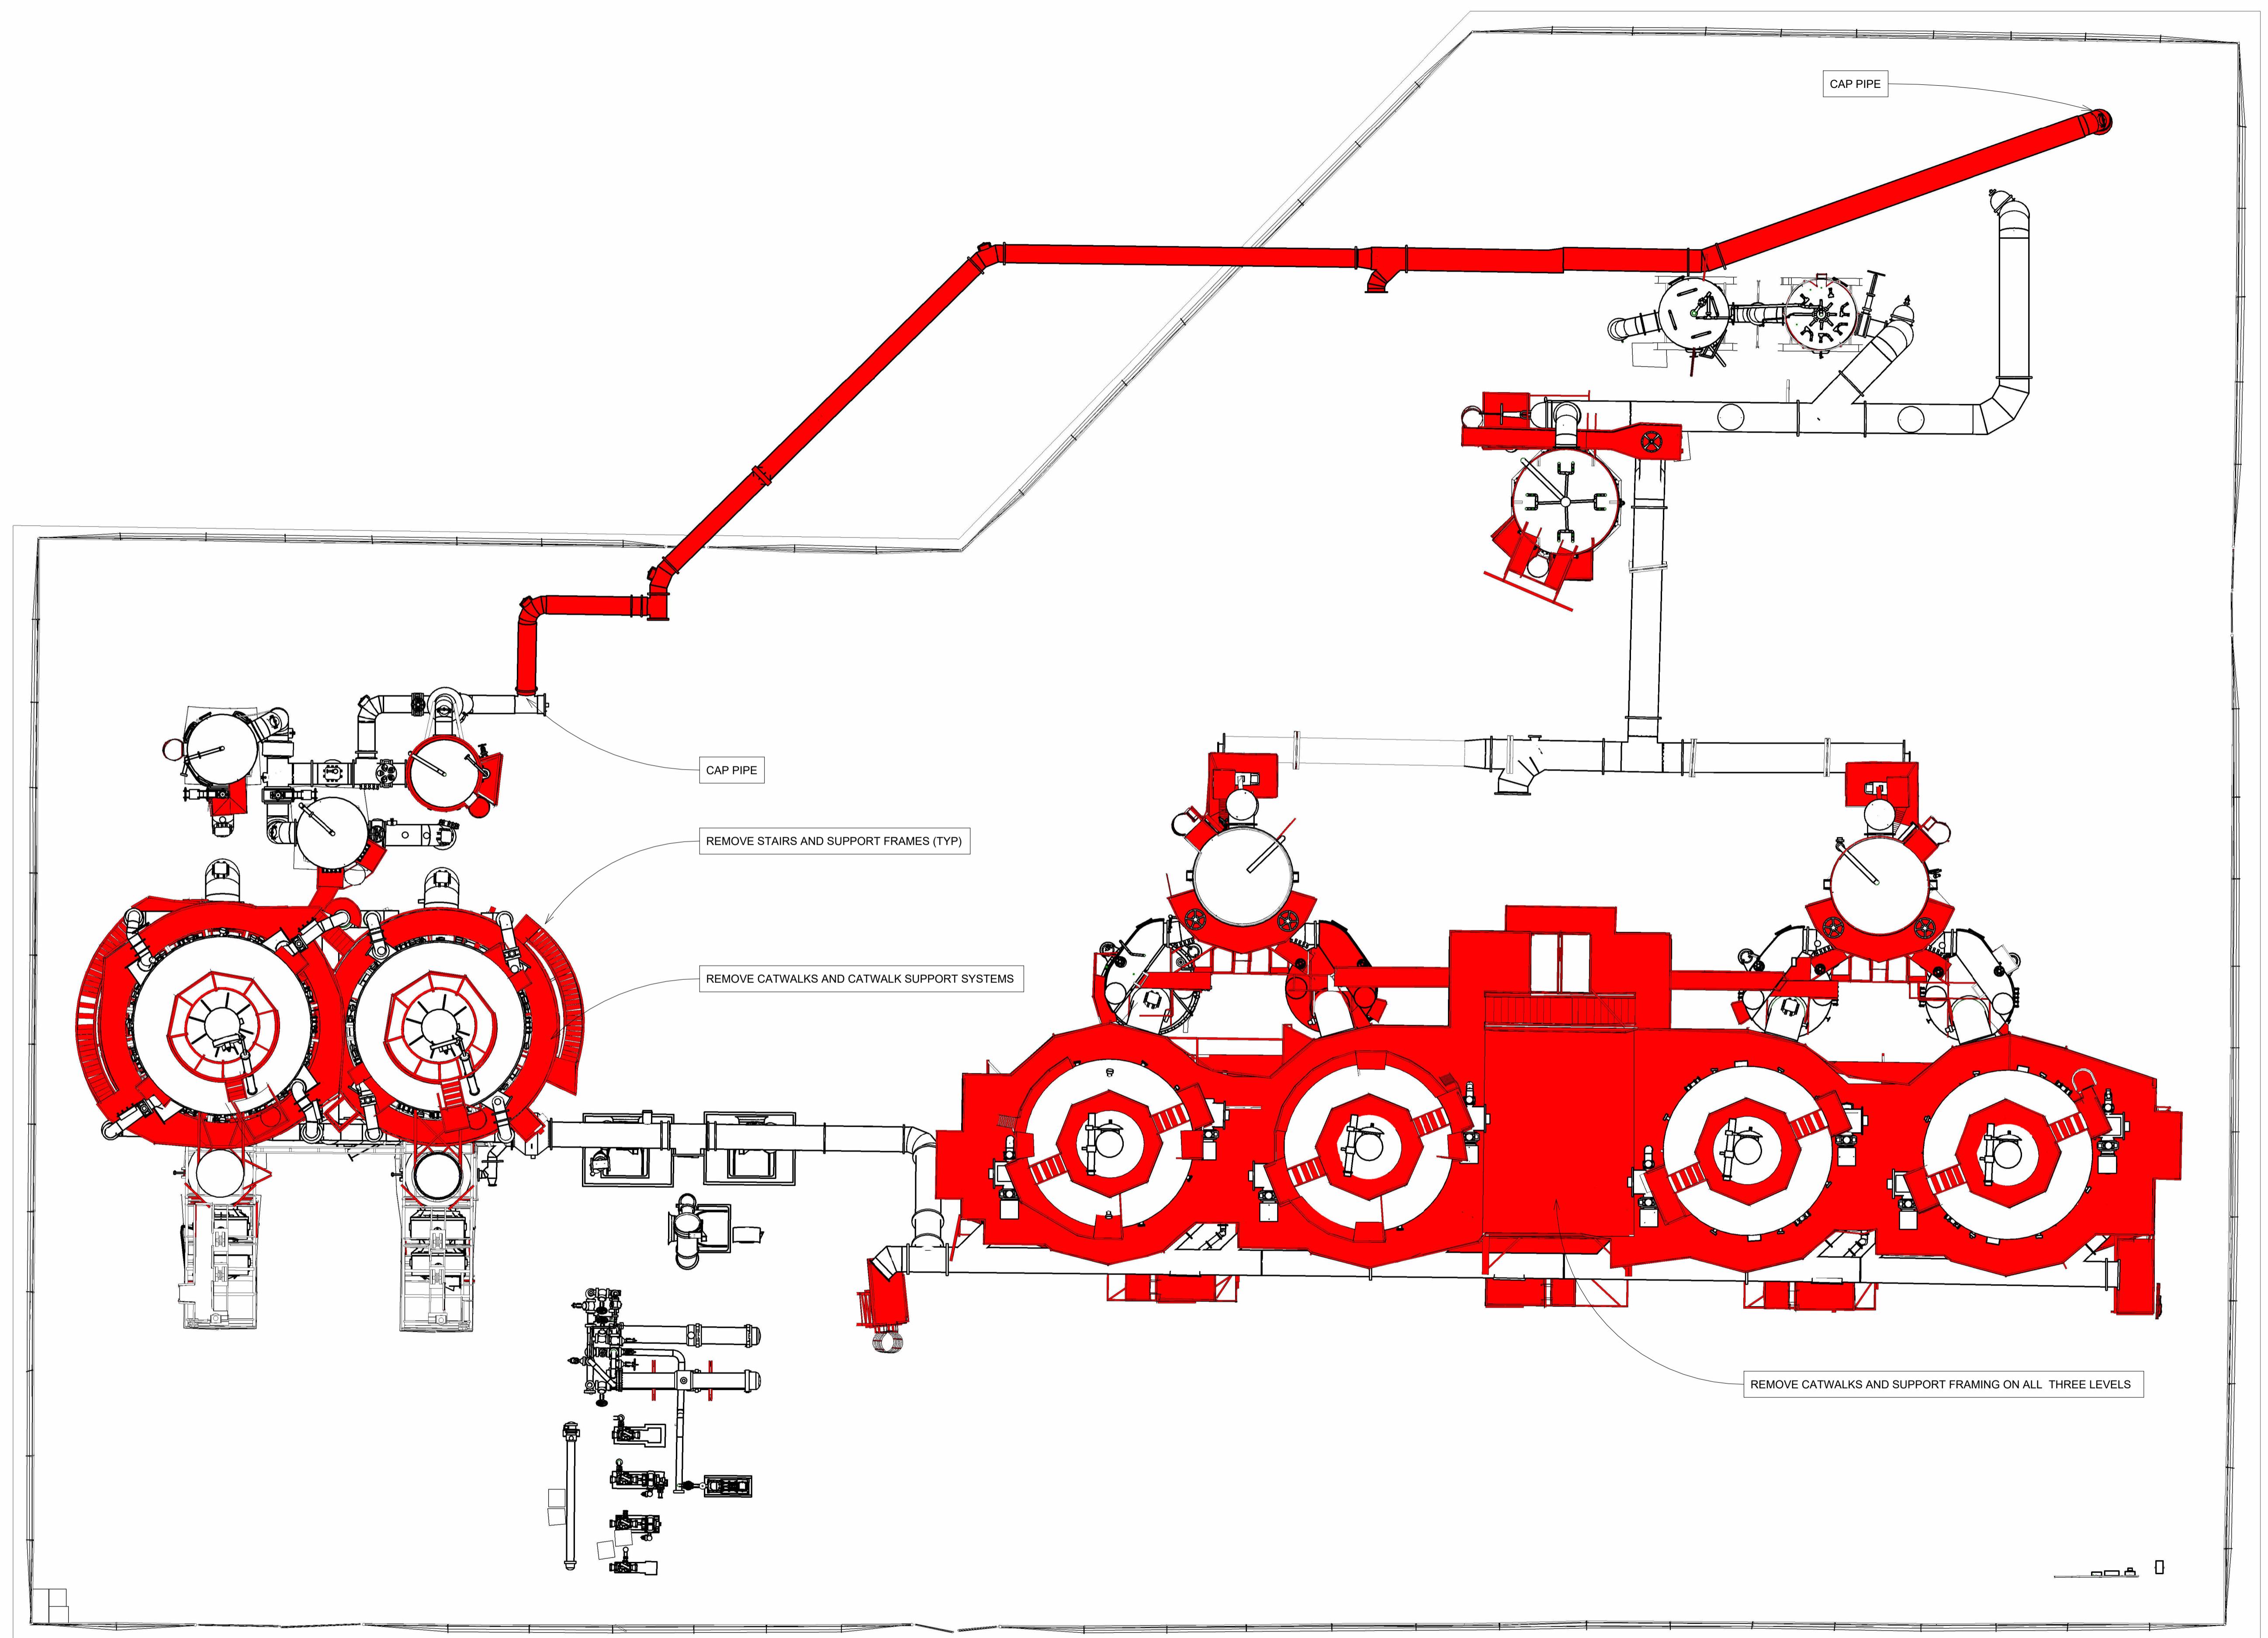

① SELECTIVE DECONSTRUCTION PLAN  
AS NOTED

0' 5' 10' 20' 40'

APPROVED FOR ADVERTISING:  
FAS PURCHASING AND CONTRACTING DIRECTOR

Seattle, Washington \_\_\_\_\_ Date \_\_\_\_\_

Signature: \_\_\_\_\_ Director, Purchasing & Contracting

3 \_\_\_\_\_  
2 \_\_\_\_\_  
1 \_\_\_\_\_

NO. \_\_\_\_\_ REVISION - AS BUILT DATE \_\_\_\_\_

REVIEWED: PARK ENGINEER \_\_\_\_\_ DATE \_\_\_\_\_

All work done in accordance with the City of Seattle Standard Plans and Specifications in effect on the date shown above, and supplemented by Special Provisions.

6273 REGISTERED  
ARCHITECT  
Jerry D. Osborn  
STATE OF WASHINGTON

**OAI** ARCHITECTURE + PLANNING

1001 SW Klickitat Way, Ste #204 | Seattle, WA 98134  
p. (206) 631-8442 | <http://www.oais.com>

 Seattle Parks & Recreation

GAS WORKS PARK

EMERGENCY DEMOLITION

SELECTIVE DECONSTRUCTION  
PLAN

DESIGNED \_\_\_\_\_ Author \_\_\_\_\_ DATE 08/07/25

DRAWN \_\_\_\_\_ Designer \_\_\_\_\_

CHECKED \_\_\_\_\_ Checker \_\_\_\_\_ SHEET \_\_\_\_\_ OF \_\_\_\_\_

ORDINANCE NO. \_\_\_\_\_

CONTRACT NO. \_\_\_\_\_

SCALE AS NOTED (U.N.O.)



**D1.02**

#### SCOPE OF DEMOLITION

1. DEMOLISH (E) PIPING
2. DEMOLISH (E) RAILING
3. DEMOLISH (E) CATWALKS
4. DEMOLISH (E) CATWALK SUPPORT STRUCTURE
5. DEMOLISH (E) LADDER ASSEMBLY AND SUPPORT SYSTEM
6. DEMOLISH (E) PIPE SUPPORTS - CUT OFF FLUSH WITH GRADE

#### GENERAL NOTES

- REMOVE ALL ELEMENTS INDICATED IN RED.
- APPLY "CORROSIONX HD" CORROSION-INHIBITING COATING (OR APPROVED EQUIVALENT) TO ALL EXPOSED STEEL THAT HAS BEEN CUT OR TORCHED.
- CAP EXISTING PIPE AT CUT/TORCH LOCATIONS USING A 1/2" STEEL PLATE, FIELD-WELDED TO THE PIPE END. PAINT THE CAP AND WELDS WITH THE SPECIFIED CORROSION-INHIBITING COATING.
- SCOPE INCLUDES REMOVAL OF CATWALKS, LADDERS, AND ASSOCIATED SUPPORT FRAMING. REVIEW IN-FIELD CONDITIONS WHERE PIPING SYSTEMS NOT SCHEDULED FOR REMOVAL MAY BE SUPPORTED BY CATWALK STRUCTURES.
- REFER TO HAZMAT SURVEY FOR WORKER SAFETY AND DISPOSAL PROCEDURES RELATED TO LEAD-CONTAINING COATINGS.
- REMOVE ALL STRUCTURAL SUPPORTS DOWN TO GRADE. NOTE: EXISTING SOILS CONTAIN HYDROCARBONS—DO NOT DISTURB NATIVE SOIL.

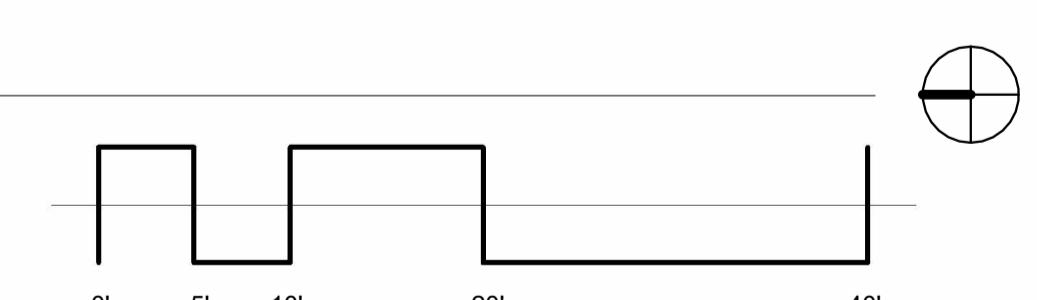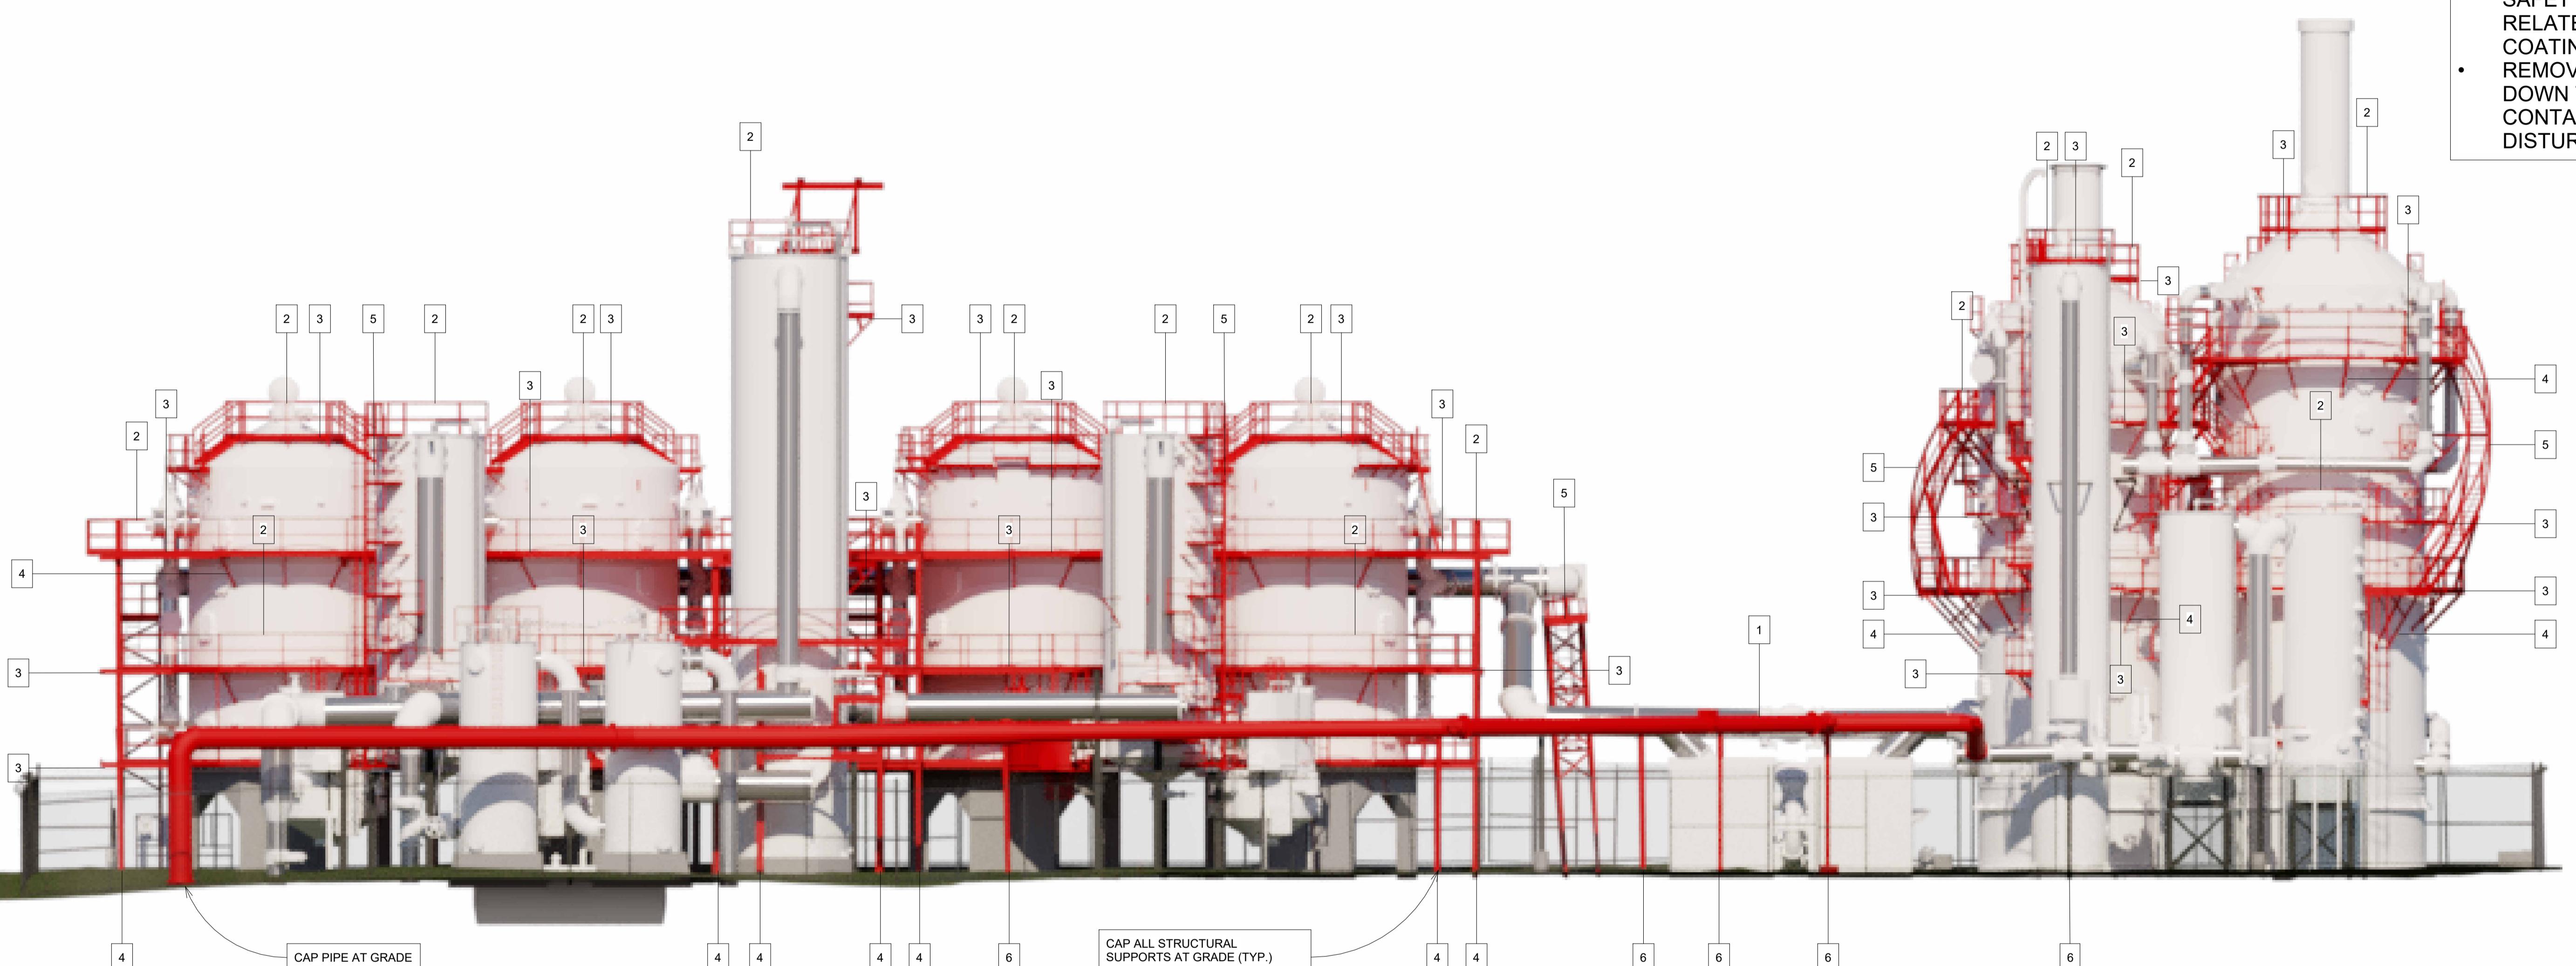

**DAI** ARCHITECTURE + PLANNING

1001 SW Klickitat Way, Ste #204 | Seattle, WA 98134  
p. (206) 631-8442 | <http://www.oapis.com>

 **Seattle**  
Parks & Recreation

**GAS WORKS PARK**

**EMERGENCY DEMOLITION**

**WEST DECONSTRUCTION ELEVATION**

DESIGNED	Author	DATE	08/07/25
DRAWN	Designer		
CHECKED	Checker		
ORDINANCE NO.			
CONTRACT NO.			
SCALE	AS NOTED	(U.N.O.)	

**D1.03**

 <p>① NORTH DECONSTRUCTION ELEVATION AS NOTED</p> <p>C:\Users\Amy\Desktop\Gas Works Park Scan_BASE.nsf 9/11/2025 11:25:50 AM</p>						<p><b>SCOPE OF DEMOLITION</b></p> <ol style="list-style-type: none"> <li>1. DEMOLISH (E) PIPING</li> <li>2. DEMOLISH (E) RAILING</li> <li>3. DEMOLISH (E) CATWALKS</li> <li>4. DEMOLISH (E) CATWALK SUPPORT STRUCTURE</li> <li>5. DEMOLISH (E) LADDER ASSEMBLY AND SUPPORT SYSTEM</li> <li>6. DEMOLISH (E) PIPE SUPPORTS - CUT OFF FLUSH WITH GRADE</li> </ol>	<p><b>GENERAL NOTES</b></p> <ul style="list-style-type: none"> <li>• REMOVE ALL ELEMENTS INDICATED IN RED.</li> <li>• APPLY "CORROSIONX HD" CORROSION-INHIBITING COATING (OR APPROVED EQUIVALENT) TO ALL EXPOSED STEEL THAT HAS BEEN CUT OR TORCHED.</li> <li>• CAP EXISTING PIPE AT CUT/TORCH LOCATIONS USING A 1/2" STEEL PLATE, FIELD-WELDED TO THE PIPE END. PAINT THE CAP AND WELDS WITH THE SPECIFIED CORROSION-INHIBITING COATING.</li> <li>• SCOPE INCLUDES REMOVAL OF CATWALKS, LADDERS, AND ASSOCIATED SUPPORT FRAMING. REVIEW IN-FIELD CONDITIONS WHERE PIPING SYSTEMS NOT SCHEDULED FOR REMOVAL MAY BE SUPPORTED BY CATWALK STRUCTURES.</li> <li>• REFER TO HAZMAT SURVEY FOR WORKER SAFETY AND DISPOSAL PROCEDURES RELATED TO LEAD-CONTAINING COATINGS.</li> <li>• REMOVE ALL STRUCTURAL SUPPORTS DOWN TO GRADE. NOTE: EXISTING SOILS CONTAIN HYDROCARBONS—DO NOT DISTURB NATIVE SOIL.</li> </ul>																																		
						<p>APPROVED FOR ADVERTISING: FAS PURCHASING AND CONTRACTING DIRECTOR</p> <p>Seattle, Washington _____ Date 20_____</p> <p>Signature: _____ Director, Purchasing &amp; Contracting</p> <table border="1"> <tr> <td>3</td> <td>_____</td> </tr> <tr> <td>2</td> <td>_____</td> </tr> <tr> <td>1</td> <td>_____</td> </tr> <tr> <td>NO.</td> <td>REVISION - AS BUILT</td> </tr> <tr> <td></td> <td>DATE</td> </tr> </table> <p>REVIEWED: PARK ENGINEER _____ DATE</p> <p>All work done in accordance with the City of Seattle Standard Plans and Specifications in effect on the date shown above, and supplemented by Special Provisions.</p> <p>6273 REGISTERED ARCHITECT Jerry D. Osborn JERRY D. OSBORN STATE OF WASHINGTON</p>	3	_____	2	_____	1	_____	NO.	REVISION - AS BUILT		DATE	<p><b>DAI</b> ARCHITECTURE + PLANNING</p> <p>1001 SW Klickitat Way, Ste #204   Seattle, WA 98134 p. (206) 631-8442   <a href="http://www.oapis.com">http://www.oapis.com</a></p> <p><b>Seattle Parks &amp; Recreation</b></p> <p><b>GAS WORKS PARK</b></p> <p><b>EMERGENCY DEMOLITION</b></p> <p><b>NORTH DECONSTRUCTION ELEVATION</b></p> <table border="1"> <tr> <td>DESIGNED</td> <td>Author</td> <td>DATE</td> <td>08/07/25</td> </tr> <tr> <td>DRAWN</td> <td>Designer</td> <td></td> <td></td> </tr> <tr> <td>CHECKED</td> <td>Checker</td> <td></td> <td></td> </tr> <tr> <td>ORDINANCE NO.</td> <td></td> <td>SHEET</td> <td>OF</td> </tr> <tr> <td>CONTRACT NO.</td> <td></td> <td></td> <td></td> </tr> <tr> <td>SCALE</td> <td>AS NOTED</td> <td>(U.N.O.)</td> <td></td> </tr> </table> <p><b>D1.04</b></p>	DESIGNED	Author	DATE	08/07/25	DRAWN	Designer			CHECKED	Checker			ORDINANCE NO.		SHEET	OF	CONTRACT NO.				SCALE	AS NOTED	(U.N.O.)	
3	_____																																								
2	_____																																								
1	_____																																								
NO.	REVISION - AS BUILT																																								
	DATE																																								
DESIGNED	Author	DATE	08/07/25																																						
DRAWN	Designer																																								
CHECKED	Checker																																								
ORDINANCE NO.		SHEET	OF																																						
CONTRACT NO.																																									
SCALE	AS NOTED	(U.N.O.)																																							

**SCOPE OF DEMOLITION**

1. DEMOLISH (E) PIPING
2. DEMOLISH (E) RAILING
3. DEMOLISH (E) CATWALKS
4. DEMOLISH (E) CATWALK SUPPORT STRUCTURE
5. DEMOLISH (E) LADDER ASSEMBLY AND SUPPORT SYSTEM
6. DEMOLISH (E) PIPE SUPPORTS - CUT OFF FLUSH WITH GRADE

**GENERAL NOTES**

- REMOVE ALL ELEMENTS INDICATED IN RED.
- APPLY "CORROSIONX HD" CORROSION-INHIBITING COATING (OR APPROVED EQUIVALENT) TO ALL EXPOSED STEEL THAT HAS BEEN CUT OR TORCHED.
- CAP EXISTING PIPE AT CUT/TORCH LOCATIONS USING A 1/2" STEEL PLATE, FIELD-WELDED TO THE PIPE END. PAINT THE CAP AND WELDS WITH THE SPECIFIED CORROSION-INHIBITING COATING.
- SCOPE INCLUDES REMOVAL OF CATWALKS, LADDERS, AND ASSOCIATED SUPPORT FRAMING. REVIEW IN-FIELD CONDITIONS WHERE PIPING SYSTEMS NOT SCHEDULED FOR REMOVAL MAY BE SUPPORTED BY CATWALK STRUCTURES.
- REFER TO HAZMAT SURVEY FOR WORKER SAFETY AND DISPOSAL PROCEDURES RELATED TO LEAD-CONTAINING COATINGS.
- REMOVE ALL STRUCTURAL SUPPORTS DOWN TO GRADE. NOTE: EXISTING SOILS CONTAIN HYDROCARBONS—DO NOT DISTURB NATIVE SOIL.

APPROVED FOR ADVERTISING:  
FAS PURCHASING AND CONTRACTING DIRECTOR

Seattle, Washington \_\_\_\_\_ Date 20\_\_\_\_\_

Signature: \_\_\_\_\_ Director, Purchasing & Contracting

3	
2	
1	
NO.	REVISION - AS BUILT
	DATE

REVIEWED: PARK ENGINEER DATE

All work done in accordance with the City of Seattle Standard Plans and Specifications in effect on the date shown above, and supplemented by Special Provisions.

6273 REGISTERED  
ARCHITECT  
Jerry D. Osborn  
STATE OF WASHINGTON

**DAI** ARCHITECTURE + PLANNING

1001 SW Klickitat Way, Ste #204 | Seattle, WA 98134  
p. (206) 631-8442 | <http://www.oapis.com>

 Seattle  
Parks & Recreation


**GAS WORKS PARK**


**EMERGENCY DEMOLITION**

**SOUTH DECONSTRUCTION ELEVATION**

DESIGNED	Author	DATE	08/07/25
DRAWN	Designer		
CHECKED	Checker		
ORDINANCE NO.			
CONTRACT NO.			
SCALE	AS NOTED	(U.N.O.)	


**D1.05**

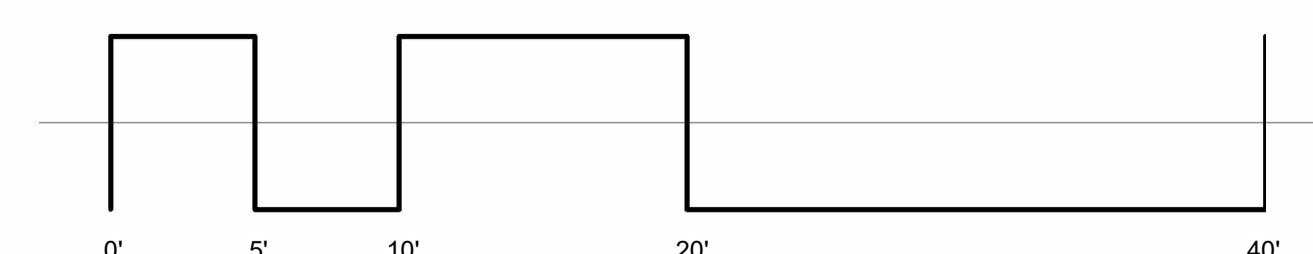

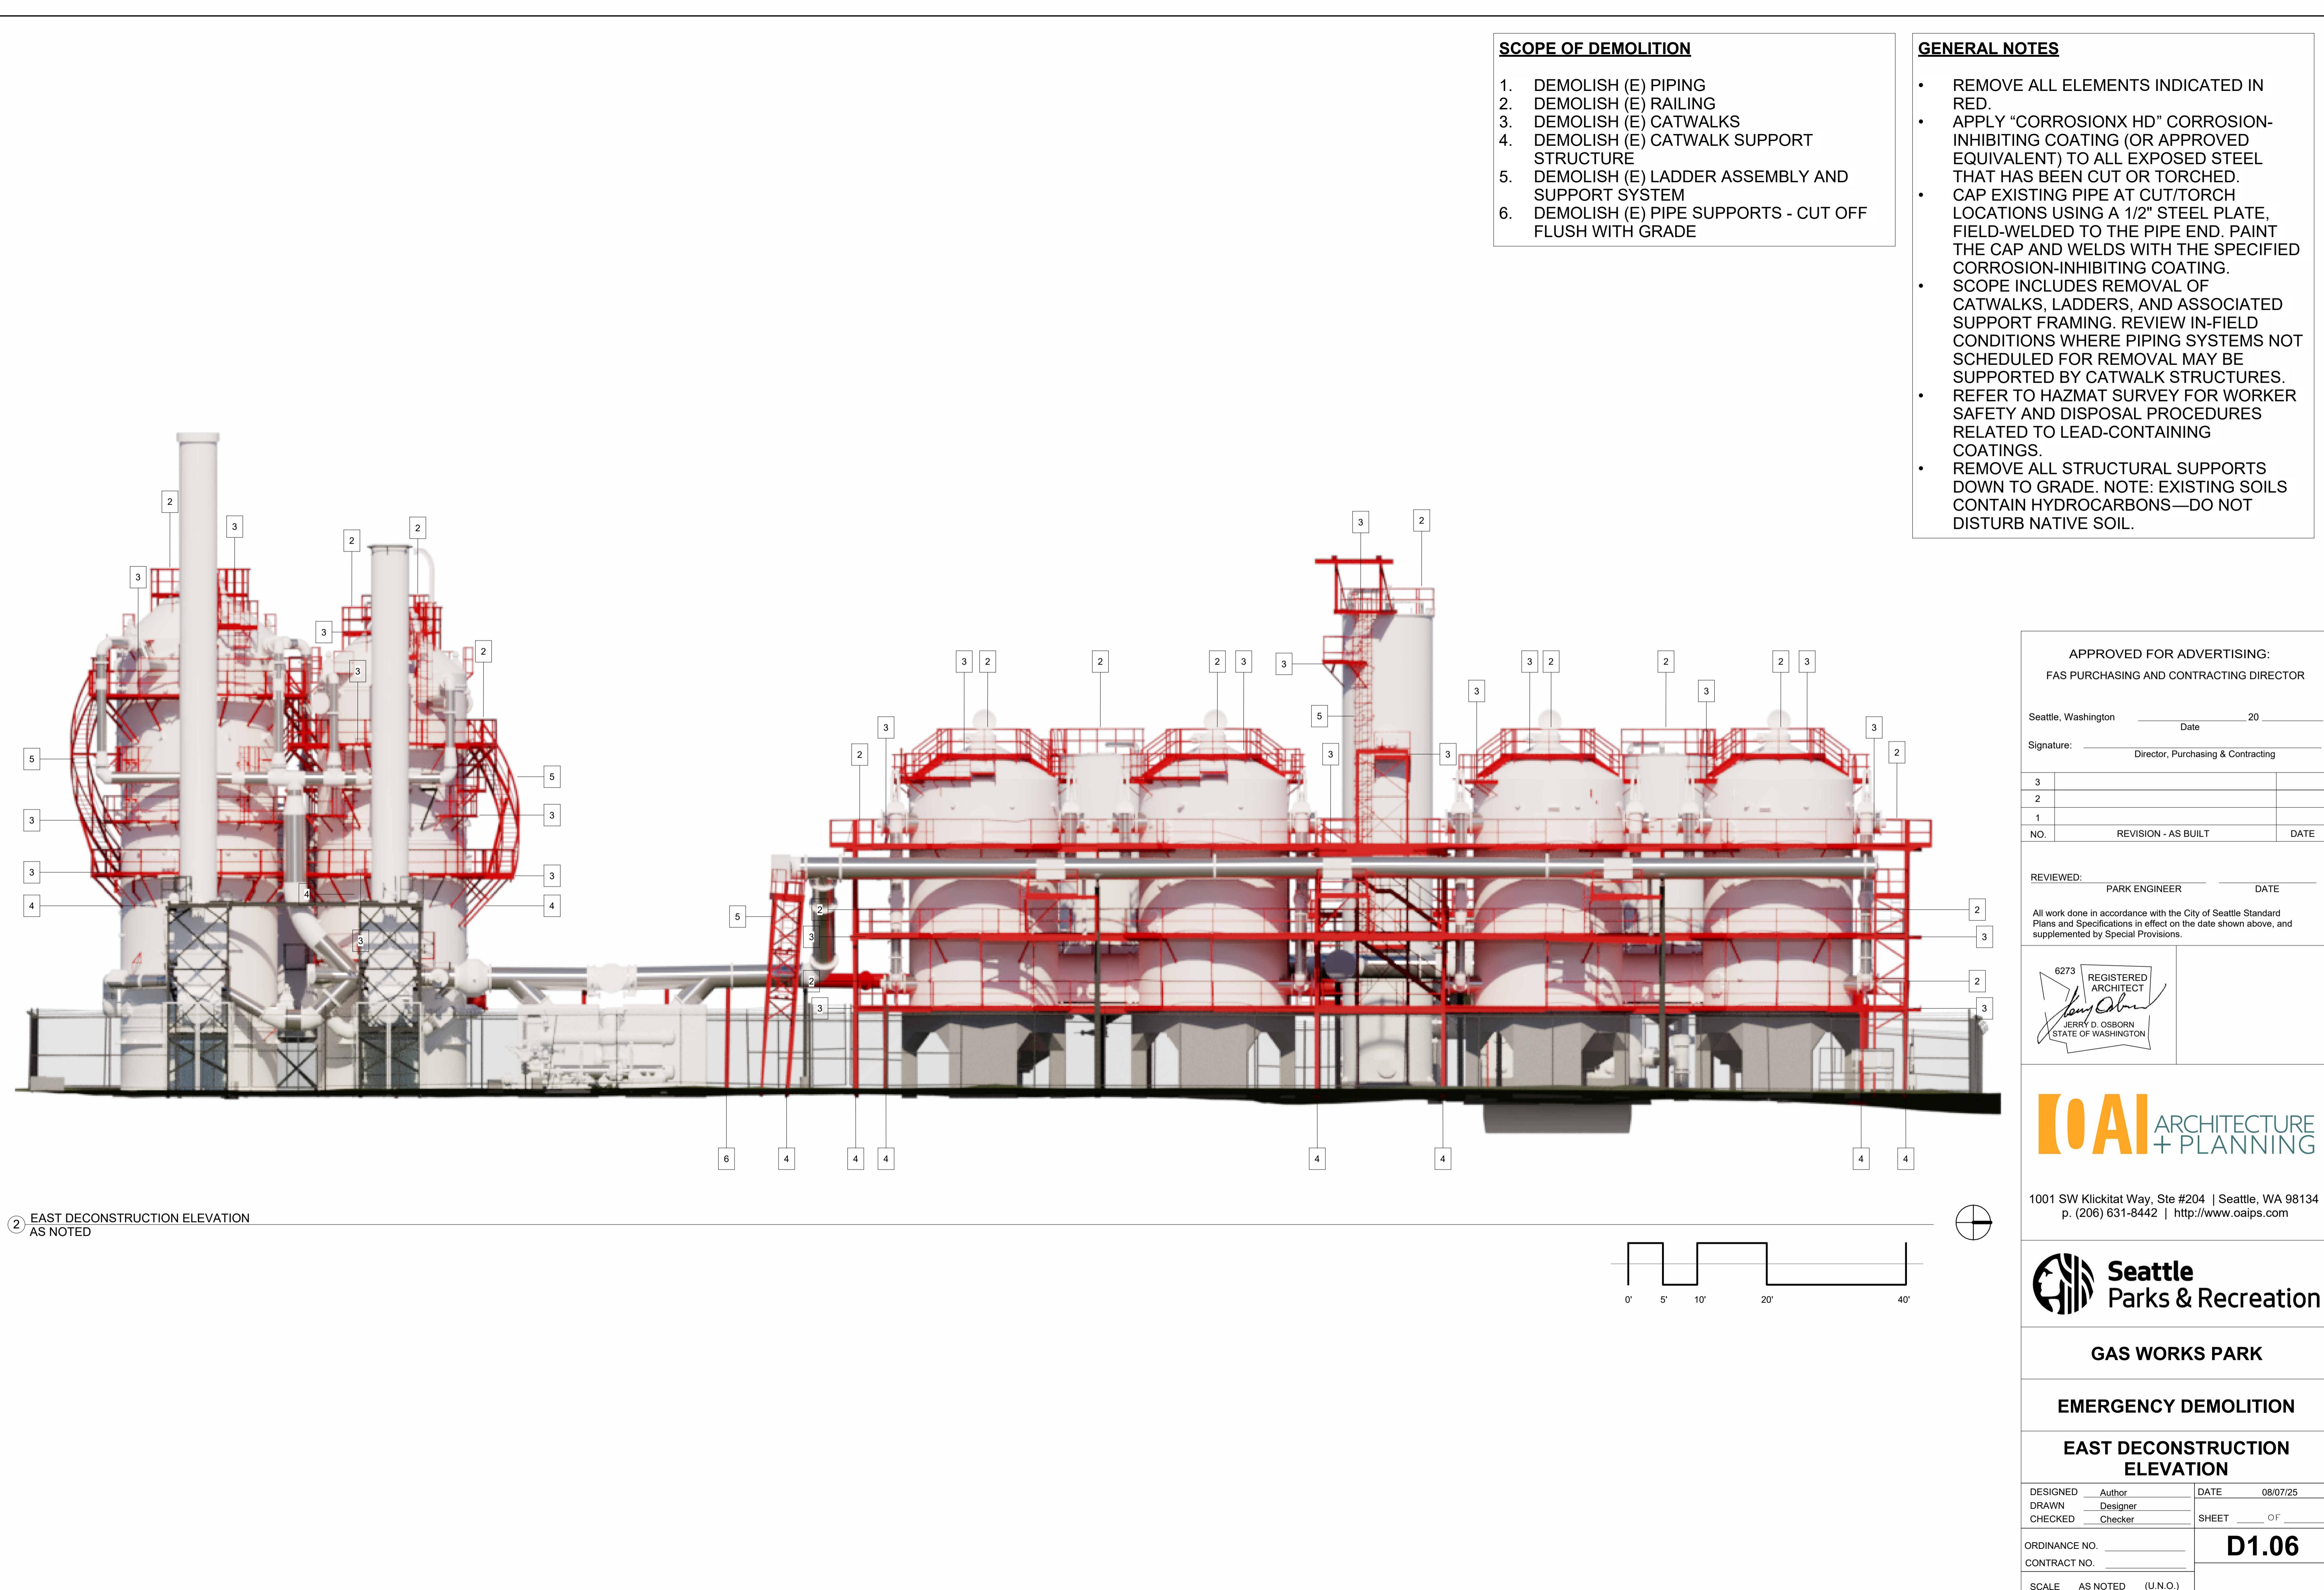


**GENERAL NOTES**

- ITEMS RENDERED IN RED ARE SELECTED FOR REMOVAL AND DISPOSAL (TYP.)
- CUT-OFF VERTICAL FRAMING AT GROUND LEVEL
  - SOIL DISTURBANCE IS EXCLUDED FROM THIS PROJECT.
- CAPPING OF UTILITY PIPING IS INCLUDED IN THE SCOPE OF THIS PROJECT.

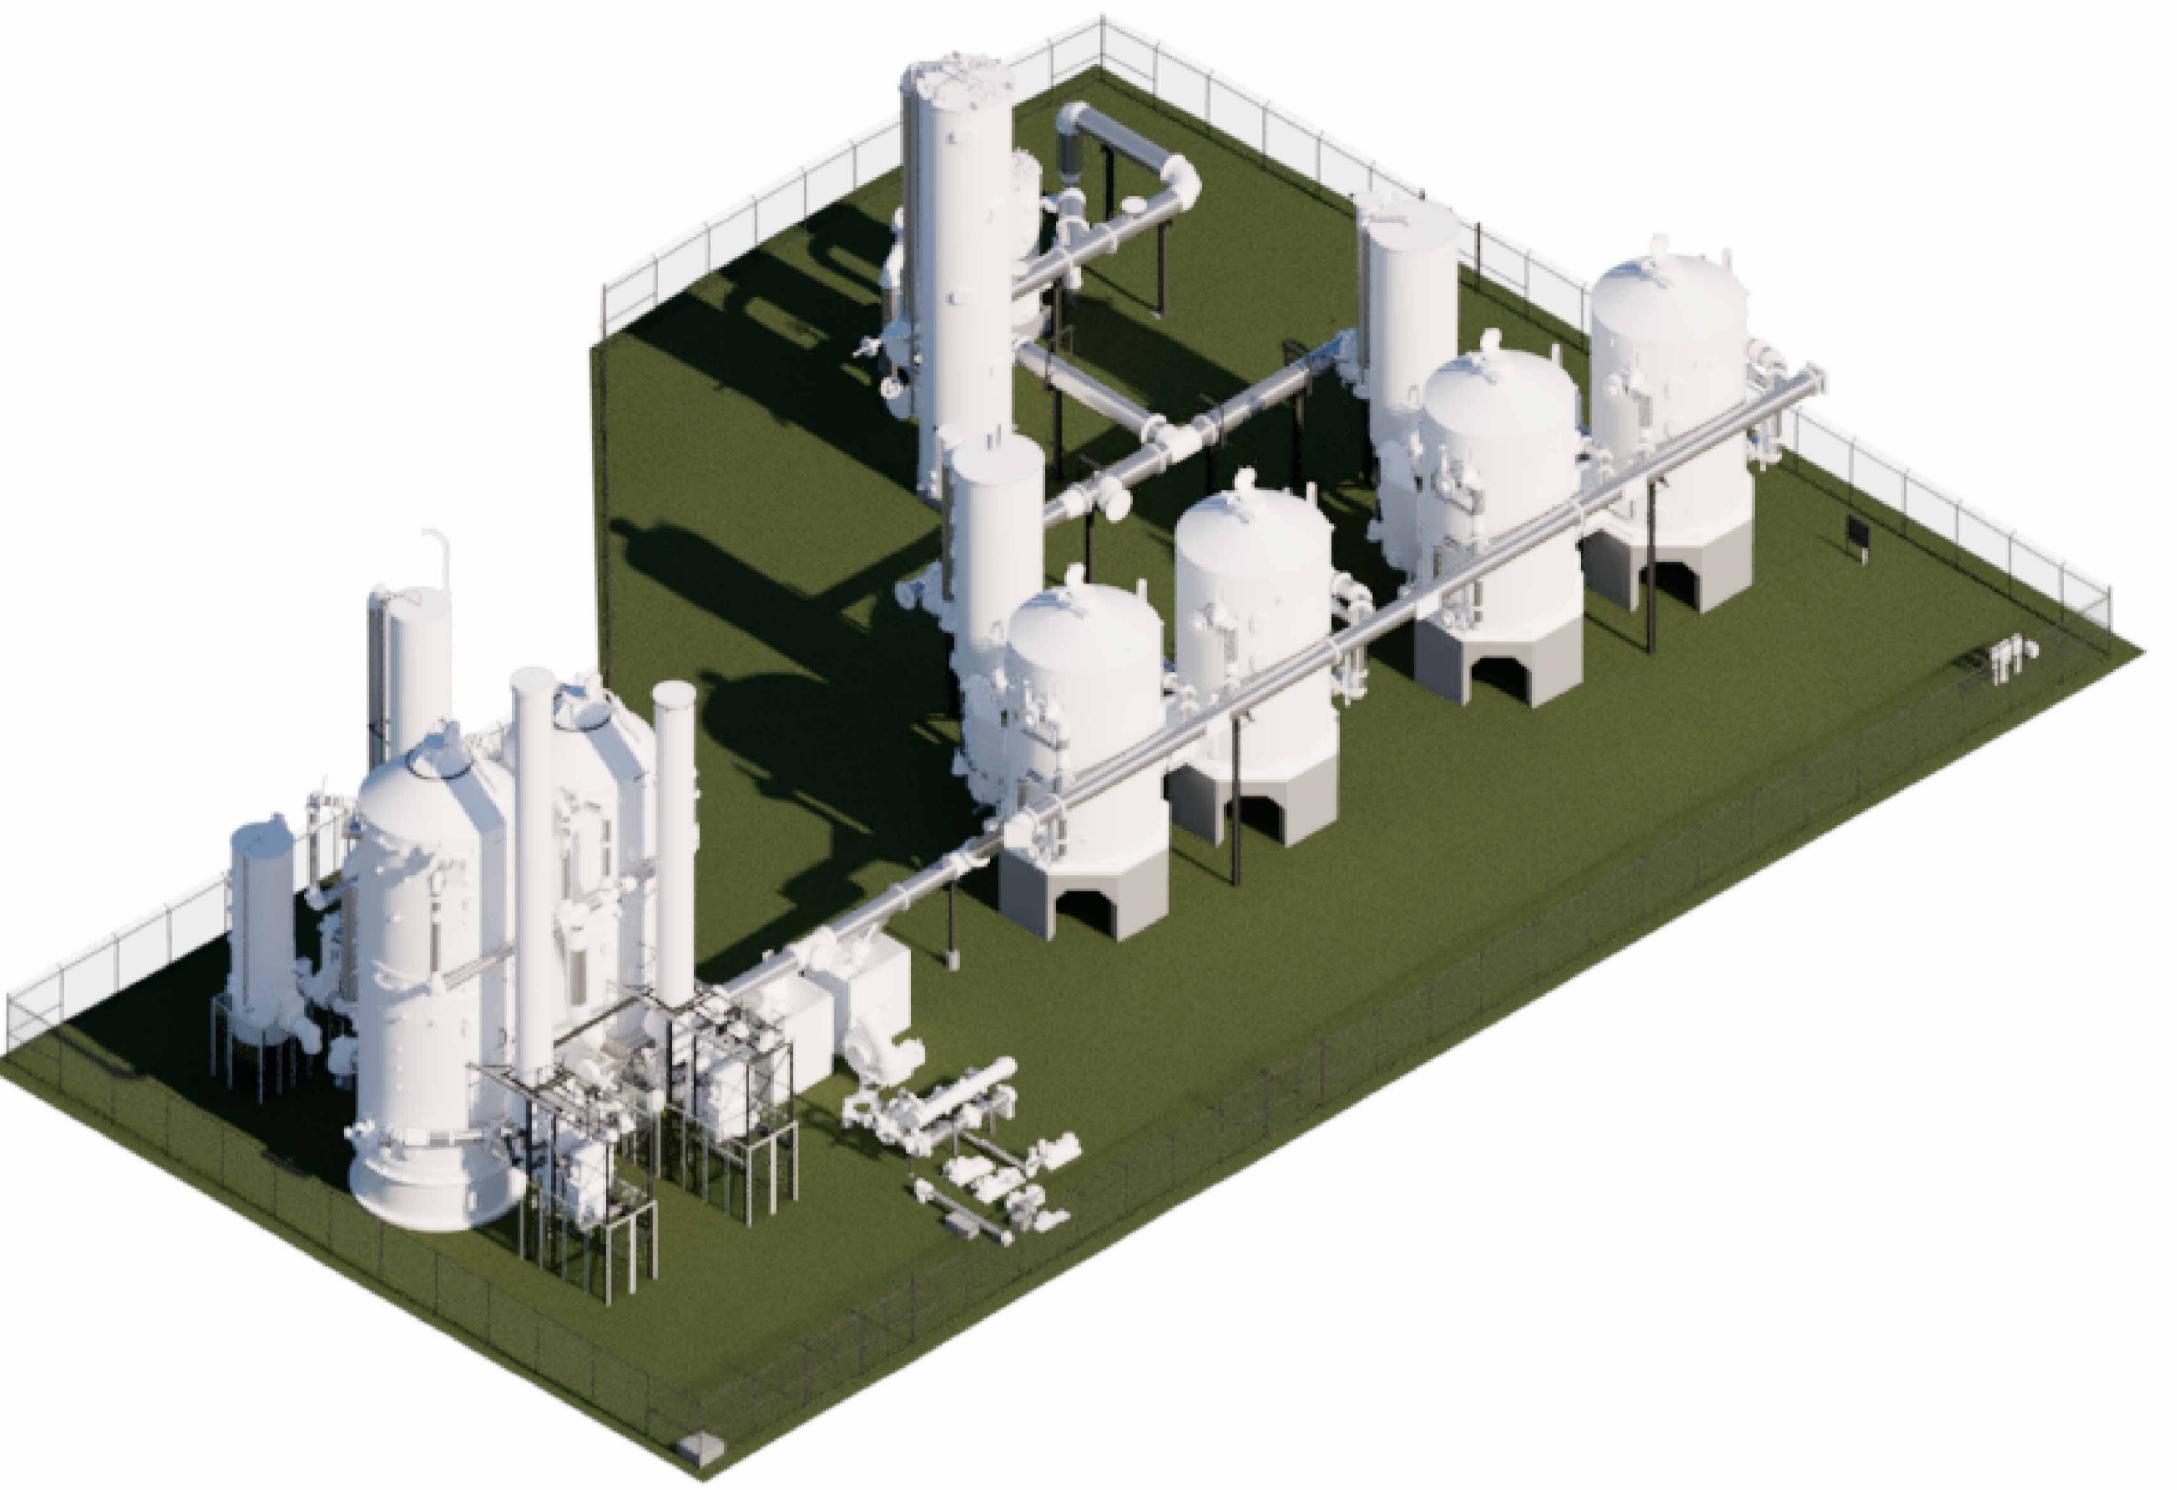


POST DECONSTRUCTION SW  
PERSPECTIVE  
① NTS

POST DECONSTRUCTION SE  
PERSPECTIVE  
② NTS

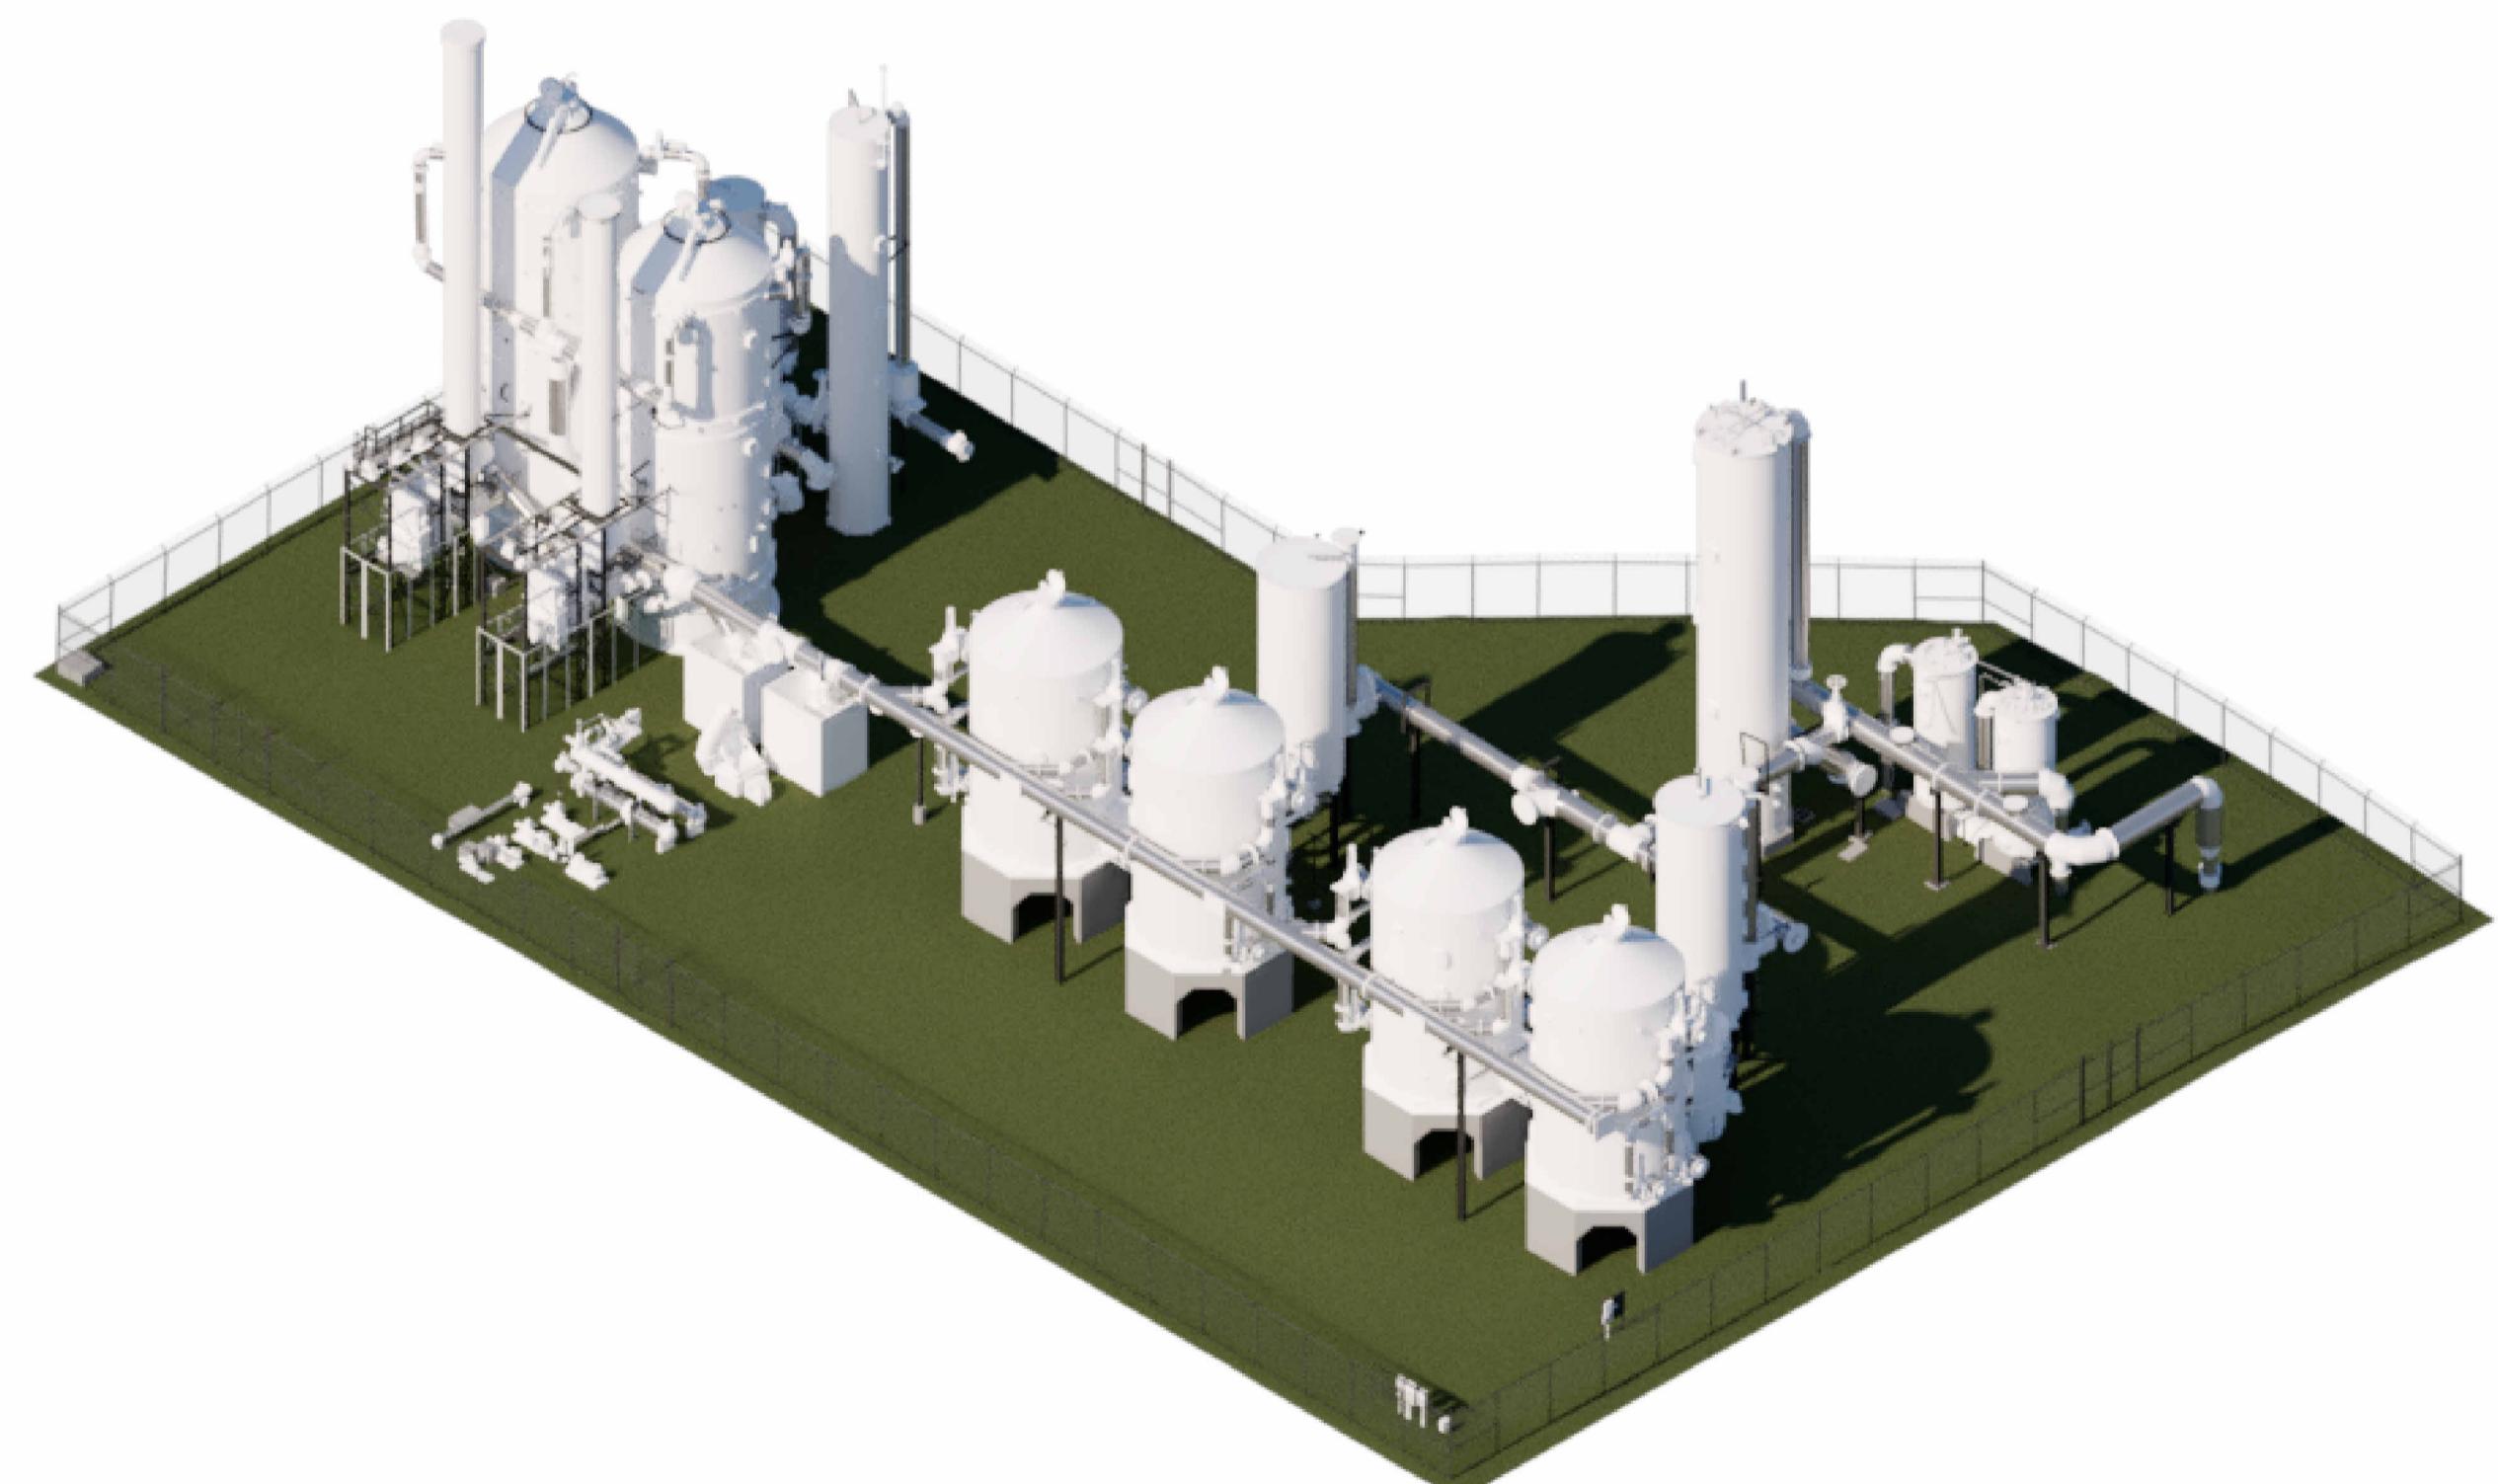

POST DECONSTRUCTION NE  
PERSPECTIVE  
③ NTS

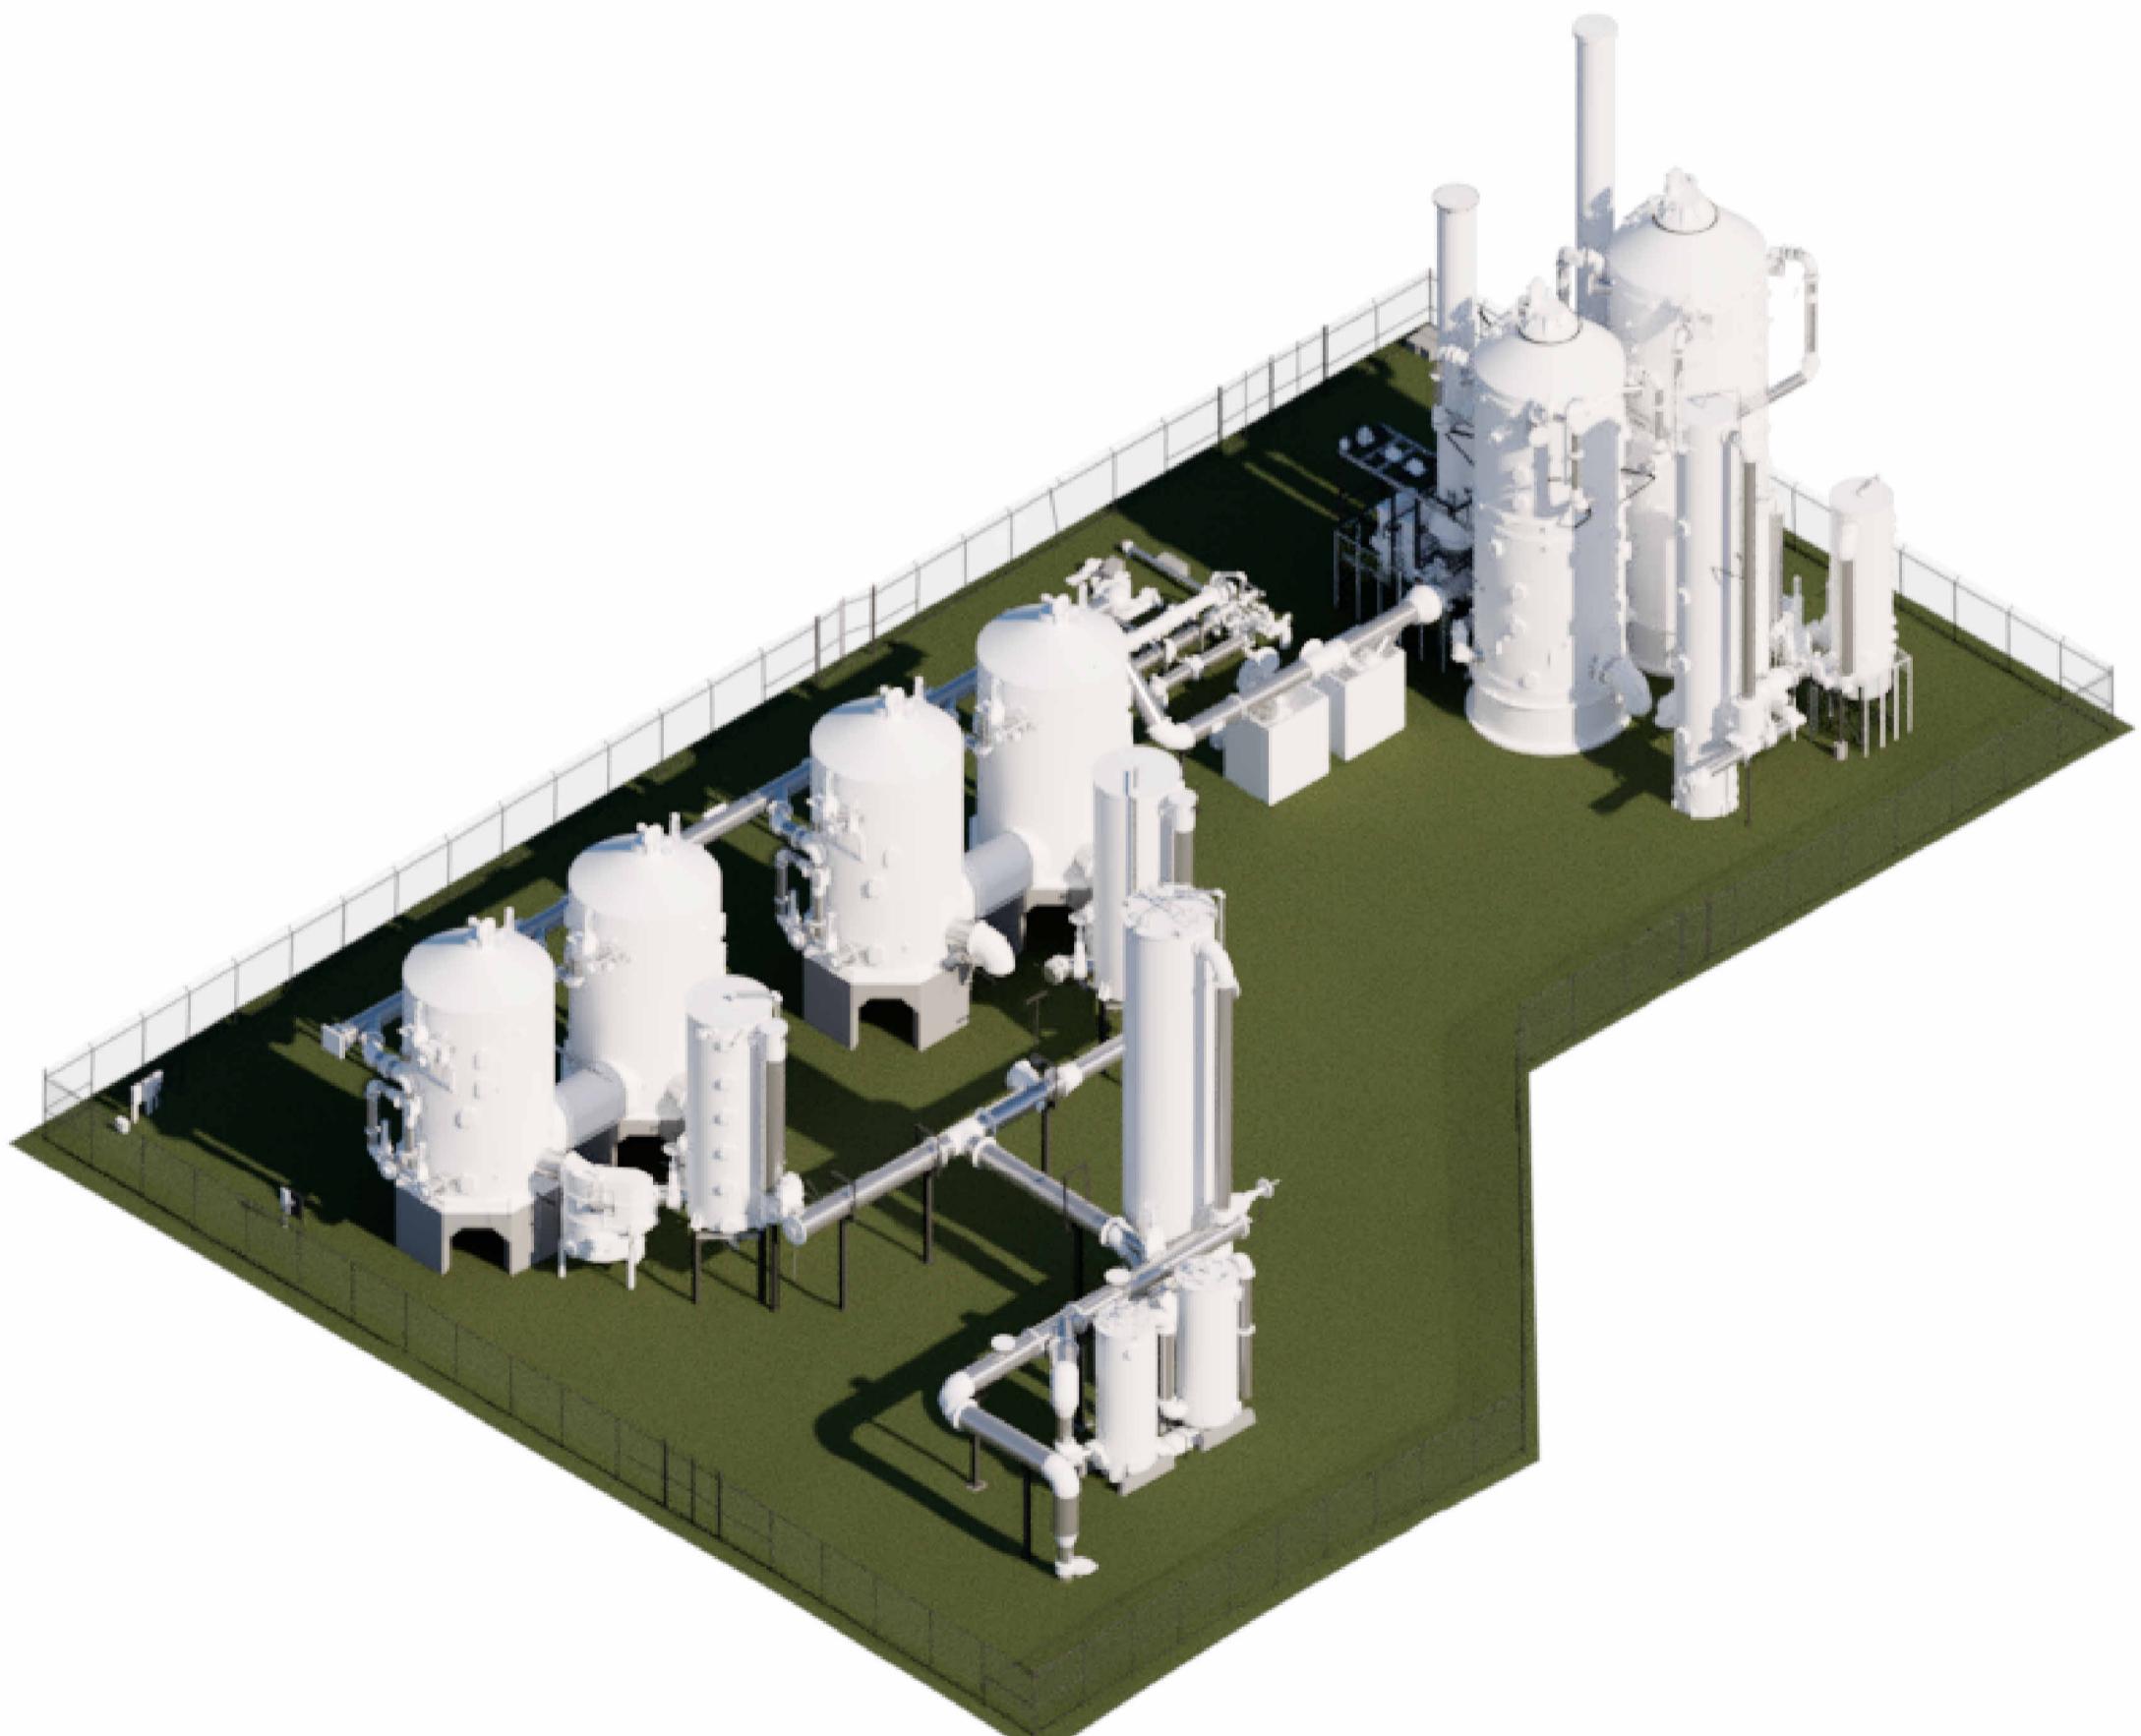

POST DECONSTRUCTION NW  
PERSPECTIVE  
④ NTS

APPROVED FOR ADVERTISING:  
FAS PURCHASING AND CONTRACTING DIRECTOR

Seattle, Washington \_\_\_\_\_ 20 \_\_\_\_\_  
Signature: \_\_\_\_\_ Director, Purchasing & Contracting

3 \_\_\_\_\_  
2 \_\_\_\_\_  
1 \_\_\_\_\_  
NO. REVISION - AS BUILT DATE

REVIEWED: PARK ENGINEER DATE  
All work done in accordance with the City of Seattle Standard Plans and Specifications in effect on the date shown above, and supplemented by Special Provisions.

6273 REGISTERED  
ARCHITECT  
Jerry D. Osborn  
STATE OF WASHINGTON

**DAI** ARCHITECTURE + PLANNING

1001 SW Klickitat Way, Ste #204 | Seattle, WA 98134  
p. (206) 631-8442 | <http://www.oapis.com>

 Seattle Parks & Recreation

GAS WORKS PARK

EMERGENCY DEMOLITION

POST DECONSTRUCTION  
PERSPECTIVE RENDERINGS

DESIGNED	Author	DATE	08/07/25
DRAWN	Designer		
CHECKED	Checker		
ORDINANCE NO.			
CONTRACT NO.			
SCALE	NTS	(U.N.O.)	

**D1.07**


**GENERAL NOTES**

- SCOPE INCLUDES REMOVAL OF CATWALKS, LADDERS, AND ASSOCIATED SUPPORT FRAMING. REVIEW IN-FIELD CONDITIONS WHERE PIPING SYSTEMS NOT SCHEDULED FOR REMOVAL MAY BE SUPPORTED BY CATWALK STRUCTURES.
- REFER TO HAZMAT SURVEY FOR WORKER SAFETY AND DISPOSAL PROCEDURES RELATED TO LEAD-CONTAINING COATINGS.
- REMOVE ALL STRUCTURAL SUPPORTS DOWN TO GRADE. NOTE: EXISTING SOILS CONTAIN HYDROCARBONS—DO NOT DISTURB NATIVE SOIL.



C:\Users\Amy\Desktop\Gas Works Park Scan.BASE.nft

① POST DECONSTRUCTION WEST ELEVATION AS NOTED

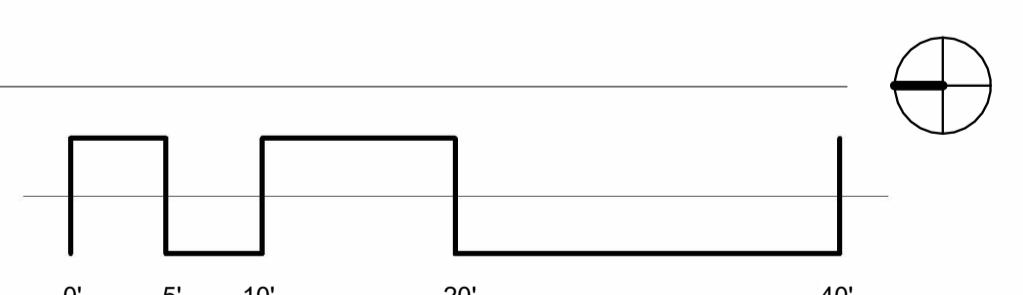

APPROVED FOR ADVERTISING:  
FAS PURCHASING AND CONTRACTING DIRECTOR

Seattle, Washington \_\_\_\_\_ Date \_\_\_\_\_

Signature: \_\_\_\_\_ Director, Purchasing & Contracting

3 \_\_\_\_\_


2 \_\_\_\_\_

1 \_\_\_\_\_

NO. \_\_\_\_\_ REVISION - AS BUILT \_\_\_\_\_ DATE \_\_\_\_\_

REVIEWED: \_\_\_\_\_ PARK ENGINEER \_\_\_\_\_ DATE \_\_\_\_\_

All work done in accordance with the City of Seattle Standard Plans and Specifications in effect on the date shown above, and supplemented by Special Provisions.

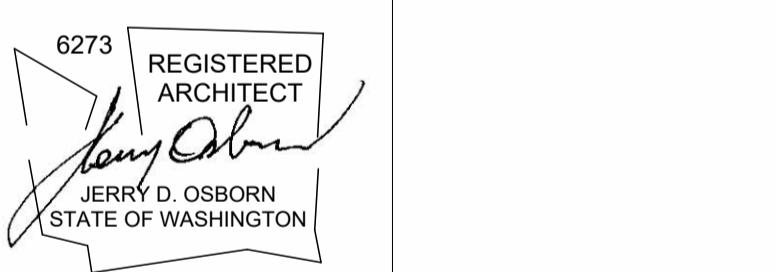6273 REGISTERED ARCHITECT  
  
JERRY D OSBORN  
STATE OF WASHINGTON

**OAI** ARCHITECTURE + PLANNING

1001 SW Klickitat Way, Ste #204 | Seattle, WA 98134  
p. (206) 631-8442 | <http://www.oapis.com>

  
**Seattle Parks & Recreation**

**GAS WORKS PARK**

**EMERGENCY DEMOLITION**

**POST DECONSTRUCTION WEST ELEVATION**

DESIGNED \_\_\_\_\_ Author \_\_\_\_\_ DATE 08/07/25

DRAWN \_\_\_\_\_ Designer \_\_\_\_\_

CHECKED \_\_\_\_\_ Checker \_\_\_\_\_

ORDINANCE NO. \_\_\_\_\_ SHEET \_\_\_\_\_ OF \_\_\_\_\_

CONTRACT NO. \_\_\_\_\_

SCALE AS NOTED (U.N.O.)

**D1.08**

**GENERAL NOTES**


- SCOPE INCLUDES REMOVAL OF CATWALKS, LADDERS, AND ASSOCIATED SUPPORT FRAMING. REVIEW IN-FIELD CONDITIONS WHERE PIPING SYSTEMS NOT SCHEDULED FOR REMOVAL MAY BE SUPPORTED BY CATWALK STRUCTURES.
- REFER TO HAZMAT SURVEY FOR WORKER SAFETY AND DISPOSAL PROCEDURES RELATED TO LEAD-CONTAINING COATINGS.
- REMOVE ALL STRUCTURAL SUPPORTS DOWN TO GRADE. NOTE: EXISTING SOILS CONTAIN HYDROCARBONS—DO NOT DISTURB NATIVE SOIL.



C:\Users\Amy\Desktop\Gas Works Park Scan\_BASE.nft

① POST DECONSTRUCTION NORTH  
ELEVATION  
AS NOTED

9/11/2025 11:31:06 AM

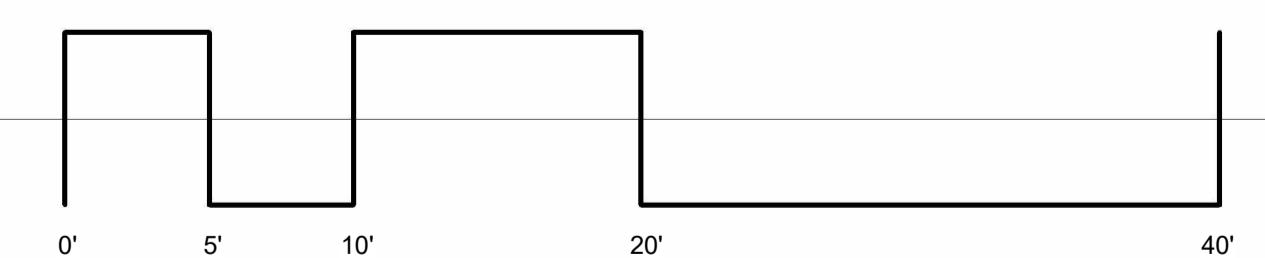APPROVED FOR ADVERTISING:  
FAS PURCHASING AND CONTRACTING DIRECTOR

Seattle, Washington \_\_\_\_\_ Date \_\_\_\_\_

Signature: \_\_\_\_\_ Director, Purchasing &amp; Contracting

3 \_\_\_\_\_

2 \_\_\_\_\_

1 \_\_\_\_\_

NO. REVISION - AS BUILT DATE

REVIEWED: PARK ENGINEER DATE

All work done in accordance with the City of Seattle Standard Plans and Specifications in effect on the date shown above, and supplemented by Special Provisions.



6273 REGISTERED  
ARCHITECT  
Jerry D. Osborn  
STATE OF WASHINGTON



OAI ARCHITECTURE  
+ PLANNING

1001 SW Klickitat Way, Ste #204 | Seattle, WA 98134  
p. (206) 631-8442 | <http://www.oaisp.com>

Seattle  
Parks & Recreation

GAS WORKS PARK

EMERGENCY DEMOLITION

POST DECONSTRUCTION  
NORTH ELEVATION

DESIGNED	Author	DATE	08/07/25
DRAWN	Designer		
CHECKED	Checker	SHEET	OF
ORDINANCE NO.			
CONTRACT NO.			
SCALE	AS NOTED	(U.N.O.)	

D1.09

**GENERAL NOTES**


- SCOPE INCLUDES REMOVAL OF CATWALKS, LADDERS, AND ASSOCIATED SUPPORT FRAMING. REVIEW IN-FIELD CONDITIONS WHERE PIPING SYSTEMS NOT SCHEDULED FOR REMOVAL MAY BE SUPPORTED BY CATWALK STRUCTURES.
- REFER TO HAZMAT SURVEY FOR WORKER SAFETY AND DISPOSAL PROCEDURES RELATED TO LEAD-CONTAINING COATINGS.
- REMOVE ALL STRUCTURAL SUPPORTS DOWN TO GRADE. NOTE: EXISTING SOILS CONTAIN HYDROCARBONS—DO NOT DISTURB NATIVE SOIL.




C:\Users\Amy\Desktop\Gas Works Park Scan\_BASE.nit

POST DECONSTRUCTION SOUTH  
ELEVATION  
AS NOTED  
②

9/11/2025 11:39 AM

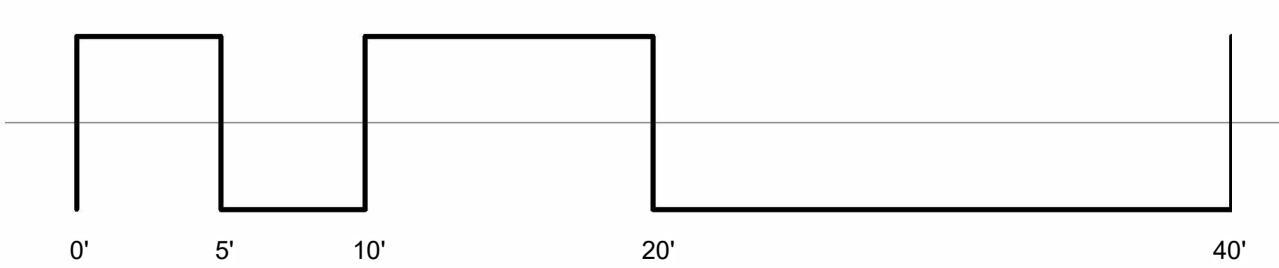

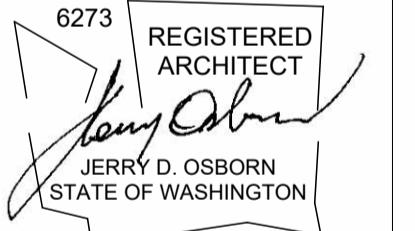APPROVED FOR ADVERTISING:		
FAS PURCHASING AND CONTRACTING DIRECTOR		
Seattle, Washington _____ Date _____		
Signature: _____ Director, Purchasing & Contracting		
3	_____	
2	_____	
1	_____	
NO.	REVISION - AS BUILT	DATE
REVIEWED: PARK ENGINEER DATE		
All work done in accordance with the City of Seattle Standard Plans and Specifications in effect on the date shown above, and supplemented by Special Provisions.		
 6273 REGISTERED ARCHITECT JERRY D. OSBORN STATE OF WASHINGTON		

**DAI** ARCHITECTURE + PLANNING  
1001 SW Klickitat Way, Ste #204 | Seattle, WA 98134  
p. (206) 631-8442 | <http://www.oaisp.com>

 **Seattle Parks & Recreation**


**GAS WORKS PARK****EMERGENCY DEMOLITION****POST DECONSTRUCTION  
SOUTH ELEVATION**

DESIGNED	Author	DATE	08/07/25
DRAWN	Designer		
CHECKED	Checker	SHEET	OF _____
ORDINANCE NO. _____		CONTRACT NO. _____	
SCALE AS NOTED (U.N.O.)			


**D1.10**

**GENERAL NOTES**

- SCOPE INCLUDES REMOVAL OF CATWALKS, LADDERS, AND ASSOCIATED SUPPORT FRAMING. REVIEW IN-FIELD CONDITIONS WHERE PIPING SYSTEMS NOT SCHEDULED FOR REMOVAL MAY BE SUPPORTED BY CATWALK STRUCTURES.
- REFER TO HAZMAT SURVEY FOR WORKER SAFETY AND DISPOSAL PROCEDURES RELATED TO LEAD-CONTAINING COATINGS.
- REMOVE ALL STRUCTURAL SUPPORTS DOWN TO GRADE. NOTE: EXISTING SOILS CONTAIN HYDROCARBONS—DO NOT DISTURB NATIVE SOIL.

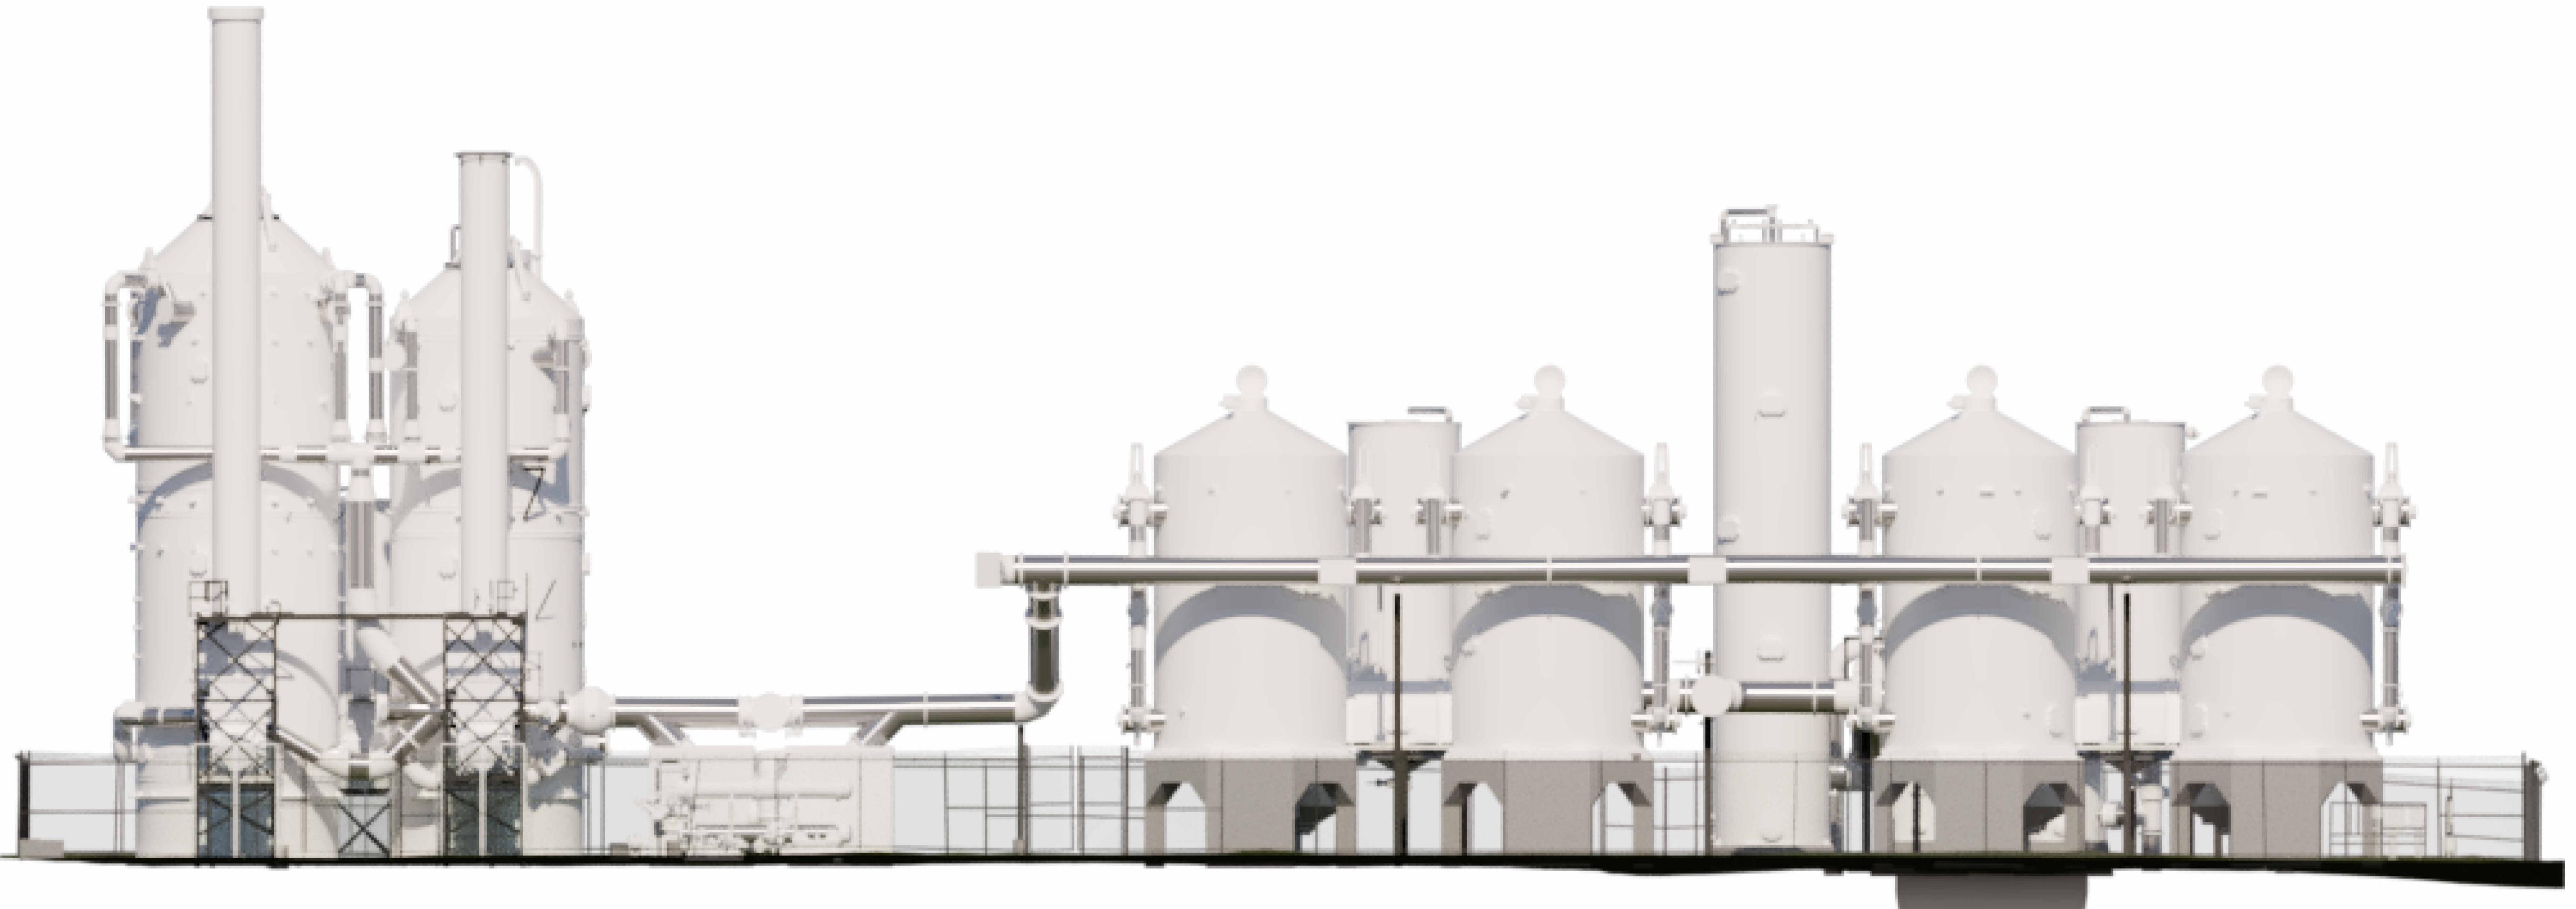

POST DECONSTRUCTION EAST  
ELEVATION  
AS NOTED  
②

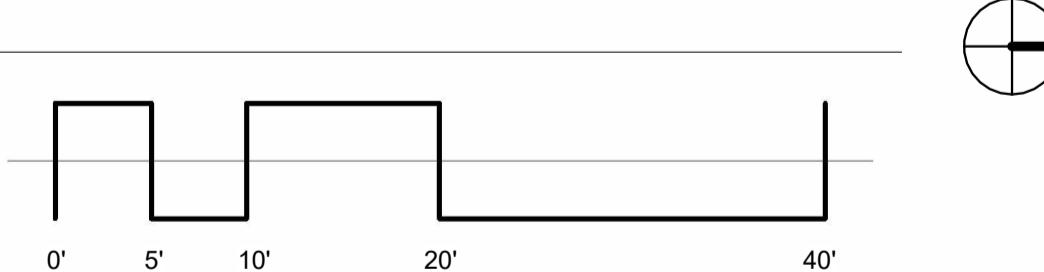

APPROVED FOR ADVERTISING:  
FAS PURCHASING AND CONTRACTING DIRECTOR

Seattle, Washington \_\_\_\_\_ Date \_\_\_\_\_

Signature: \_\_\_\_\_ Director, Purchasing & Contracting

3 \_\_\_\_\_  
2 \_\_\_\_\_  
1 \_\_\_\_\_

NO. \_\_\_\_\_ REVISION - AS BUILT \_\_\_\_\_ DATE \_\_\_\_\_

REVIEWED: \_\_\_\_\_ PARK ENGINEER \_\_\_\_\_ DATE \_\_\_\_\_

All work done in accordance with the City of Seattle Standard Plans and Specifications in effect on the date shown above, and supplemented by Special Provisions.

6273 REGISTERED  
ARCHITECT  
Jerry Osborn  
JERRY D OSBORN  
STATE OF WASHINGTON

**OAI** ARCHITECTURE  
+ PLANNING

1001 SW Klickitat Way, Ste #204 | Seattle, WA 98134  
p. (206) 631-8442 | <http://www.oapis.com>

 Seattle  
Parks & Recreation

GAS WORKS PARK

EMERGENCY DEMOLITION

POST DECONSTRUCTION EAST  
ELEVATION

DESIGNED	Author	DATE	08/07/25
DRAWN	Designer		
CHECKED	Checker	SHEET	OF
ORDINANCE NO.			
CONTRACT NO.			
SCALE	AS NOTED	(U.N.O.)	

**D1.11**